


CERTIFIED RECORD OF LAND CORNER MONUMENTATION

History of original corner establishment:

Not previously set.

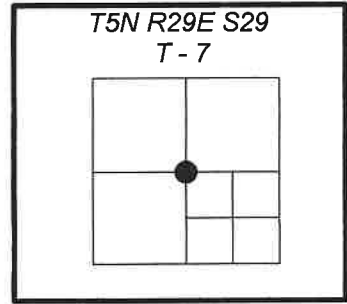

Description of corner evidence found:


N/A

Description of monument and accessories I established to perpetuate original location of this corner:

At a proportioned position along the East-West centerline of Section 29, per Umatilla County Survey 15-121-B and Partition Plat 2002-34; I set a 5/8 x 30 inch iron rod with a 2 inch aluminum cap mkd: as shown, in the center of Spearman Road, flush with the pavement.

From which:

- (RM 1) A 5/8 x 30 inch iron rod with 1 1/2 inch aluminum cap mkd.: WALLOWA ASSOCIATES NE RP 23.09 FT, bears N 53°12' E, 23.09 ft. dist., in an East-West fence.
- (RM 2) A 5/8 x 30 inch iron rod with 1 1/2 inch aluminum cap mkd.: WALLOWA ASSOCIATES SE RP 23.76 FT, bears S 42°08' E, 23.75 ft. dist., in an East-West fence.
- (RM 3) A 5/8 x 30 inch iron rod with 1 1/2 inch aluminum cap mkd.: WALLOWA ASSOCIATES SW RP 36.22 FT, bears S 61°46' W, 36.23 ft. dist., in an East-West fence.
- (RM 4) A 2 1/2 inch long MAG nail with a 1 1/2 inch stainless steel washer mkd.: WALLOWA ASSOCIATES LS 91201, in SE'y face of power pole #295500, bears N 42°33' W, 30.79 ft. dist. to the face of washer.

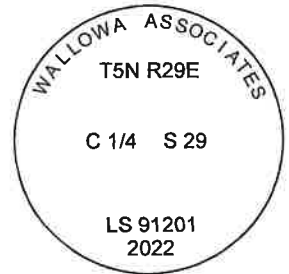

NAD 83 Geodetic Position
Lat. 45°53'09.72304" N
Long. 119°12'48.64270" W

Established by: Trimble RTK

I hereby certify that the corner is monumented and accessories taken as described, using dual frequency carrier-phase GNSS receivers.

Witnesses: Kristina Powell, David Quittschreiber and Shar Quittschreiber

REGISTERED
PROFESSIONAL
LAND SURVEYOR

Kristina Powell

OREGON
MAY 9, 2017
KRISTINA POWELL
91201

EXPIRES 12-31-22

Office of _____ County Surveyor _____ County of Umatilla
State of Oregon, I hereby certify that the within instrument was filed in this office
for record on the _____ day of _____, 20____.

(COUNTY OFFICIAL) by _____ (DEPUTY)