

OREGON CORNER RESTORATION FORM

SECTION 25, 30, 31, 36 TOWNSHIP 5 NORTH RANGE 29 EAST, RANGE 28 EAST V-1
 COUNTY : UMATILLA DATE DEC/22

CORNER DESIGNATION
 SECTION CORNER

- CONDITION REPORT ONLY
- NOT FOUND
- RENEWED
- UNCOVERED
- SURVEYED IN
- REFERENCED

PREVIOUS RENEWALS / SURVEYS, ETC.



SURVEYED IN 1861 BY DAVENPORT UNDER CONTRACT #101, HE SET POST AND MADE MOUND.
 IN 1910 KIMBRELL SET 2" IRON PIPE.
 AS PER LS 951 IN 1974 KRUMBEIN SET BRASS CAP 45' NORTH.
 IN 1984 KRUMBEIN SET 2 1/2" BRASS CAP AT IRON PIPE LOCATION.

MONUMENTS AND ACCESSORIES FOUND: CONDITION AND SOURCE

FOUND 2 1/2" BRASS CAP STAMPED AS BELOW.
 FOUND 2 1/2" BRASS CAP W.C. STAMPED AS BELOW BEARS N 08°05'16" E, 45.16'.
 FOUND 5/8" IRON ROD WITH YELLOW PLASTIC CAP STAMPED LS 951 BEARS N 78°16'16" E, 36.53'.
 FOUND 5/8" IRON ROD WITH YELLOW PLASTIC CAP STAMPED LS 951 BEARS N 21°15'34" W, 68.23'.
 FOUND 5/8" IRON ROD WITH YELLOW PLASTIC CAP STAMPED LS 951 BEARS S 36°58'06" E, 56.93'.

MONUMENT DETAIL

2 1/2" BRASS CAP W.C.

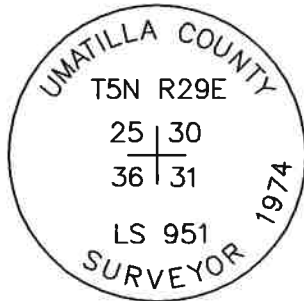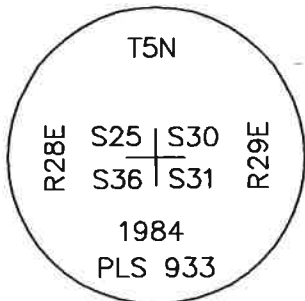

NAD 83/91
 OREGON STATE PLANE
 INTERNATIONAL FEET

809006.54
 8521773.98

MONUMENT SET (PROCEDURES AND DESCRIPTION)

NEW ACCESSORIES FROM WHICH

LOCATION AND COMMENTS

CORNER FALLS AT THE INTERSECTION
 OF WALLS ROAD AND OTT ROAD.

FIRM/AGENCY

PRIMM LAND SURVEYING, INC.
 P.O. BOX 1322
 HERMISTON, OREGON 97838

LAND SURVEYOR

BRIT L. PRIMM

WITNESS

KEITH P. PRIMM

SURVEYOR'S SEAL

REGISTERED
 PROFESSIONAL
 LAND SURVEYOR

Brit L. Primm

OREGON
 JULY 13, 1999
 BRIT L. PRIMM
 48509

EXPIRATION DATE: 12/31/24