

OREGON CORNER RESTORATION FORM

SECTION 29, 30, 31, 32 TOWNSHIP 5 NORTH RANGE 29 EAST
COUNTY : UMATILLA DATE DEC/22

V-5

CORNER DESIGNATION
SECTION CORNER

CONDITION REPORT ONLY
 NOT FOUND
 RENEWED
 UNCOVERED
 SURVEYED IN
 REFERENCED


PREVIOUS RENEWALS / SURVEYS, ETC.

SURVEYED IN 1861 BY DAVENPORT UNDER CONTRACT #101, HE SET POST AND MADE MOUND.
IN 1910 KIMBRELL SET A 3/4" IRON PIPE.
IN 1989 LS 951 SET A 2 3/8" BRASS CAP IN CONCRETE OVER IRON PIPE.

MONUMENTS AND ACCESSORIES FOUND: CONDITION AND SOURCE

FOUND 2 3/8" BRASS CAP STAMPED AS BELOW.
FOUND ALUMINUM TAG IN POWER POLE STAMPED LS 951 BEARS S 73°57'14" E, 71.18'.
FOUND ALUMINUM TAG IN RAIL ROAD TIE STAMPED LS 951 BEARS S 49°58'41" E, 33.58'.
FOUND 5/8" IRON ROD WITH YELLOW PLASTIC CAP STAMPED LS 951 BEARS S 55°51'19" W, 26.44'.

MONUMENT DETAIL

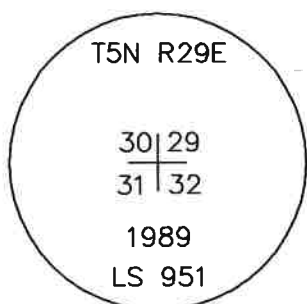

NAD 83/91
OREGON STATE PLANE
INTERNATIONAL FEET

809101.02
8527100.48

MONUMENT SET (PROCEDURES AND DESCRIPTION)

NEW ACCESSORIES FROM WHICH

SET 5/8" X 30" IRON ROD WITH YELLOW PLASTIC CAP STAMPED PLS LS 48509 BEARS N 52°29'12" E, 42.67'.

LOCATION AND COMMENTS

CORNER FALLS AT INTERSECTION OF
WALLS ROAD AND CRAIG ROAD.

FIRM/AGENCY

PRIMM LAND SURVEYING, INC.
P.O. BOX 1322
HERMISTON, OREGON 97838

LAND SURVEYOR

BRIT L. PRIMM

WITNESS

KEITH P. PRIMM

SURVEYOR'S SEAL

REGISTERED
PROFESSIONAL
LAND SURVEYOR

OREGON
JULY 13, 1999
BRIT L. PRIMM
48509

EXPIRATION DATE: 12/31/24