

# OREGON CORNER RESTORATION FORM

SECTION 31, 36 TOWNSHIP 5 NORTH RANGE 29 EAST, RANGE 28 EAST.  
COUNTY : UMATILLA DATE DEC/22

X-1

CORNER DESIGNATION

1/4 CORNER

- CONDITION REPORT ONLY
- NOT FOUND
- RENEWED
- UNCOVERED
- SURVEYED IN
- REFERENCED


PREVIOUS RENEWALS / SURVEYS, ETC.

SURVEYED IN 1861 BY DAVENPORT UNDER CONTRACT #101, HE SET POST AND MADE MOUND.  
IN 1910 KIMBRELL SET A 2" IRON PIPE.  
IN 2003 LS 951 SET A 5/8" X 30" IRON ROD INSIDE 2" IRON PIPE.

MONUMENTS AND ACCESSORIES FOUND: CONDITION AND SOURCE

FOUND 5/8" IRON ROD.  
FOUND 5/8" IRON ROD WITH YELLOW PLASTIC CAP STAMPED LS 951 BEARS S 57°25'00" E, 32.76'.  
FOUND 5/8" IRON ROD WITH YELLOW PLASTIC CAP STAMPED LS 951 BEARS N 19°29'39" W, 54.55'.  
FOUND 5/8" IRON ROD WITH YELLOW PLASTIC CAP STAMPED LS 951 BEARS S 14°47'00" W, 70.55'.  
FOUND 5/8" IRON ROD WITH YELLOW PLASTIC CAP STAMPED LS 951 BEARS S 19°06'27" E, 44.59'.

MONUMENT DETAIL

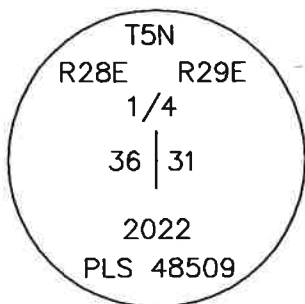

NAD 83/91  
OREGON STATE PLANE  
INTERNATIONAL FEET

806380.31  
8521815.87

MONUMENT SET ( PROCEDURES AND DESCRIPTION )

SET 2" ALUMINUM CAP STAMPED AS ABOVE (ON FOUND 5/8" IRON ROD).

NEW ACCESSORIES FROM WHICH

LOCATION AND COMMENTS

CORNER FALLS AT INTERSECTION OF  
NORTH OTT ROAD AND BEASON LANE  
(WEST COLUMBIA LANE).

FIRM/AGENCY

PRIMM LAND SURVEYING, INC.  
P.O. BOX 1322  
HERMISTON, OREGON 97838

LAND SURVEYOR

BRIT L. PRIMM

WITNESS

KEITH P. PRIMM

SURVEYOR'S SEAL

REGISTERED  
PROFESSIONAL  
LAND SURVEYOR

OREGON  
JULY 13, 1999  
BRIT L. PRIMM  
48509

EXPIRATION DATE: 12/31/24