

OREGON CORNER RESTORATION FORM

SECTION 32 TOWNSHIP 5 NORTH RANGE 29 EAST

Z-7

COUNTY : UMATILLA DATE DEC/22

CORNER DESIGNATION

1/4 CORNER

- CONDITION REPORT ONLY
- NOT FOUND
- RENEWED
- UNCOVERED
- SURVEYED IN
- REFERENCED


PREVIOUS RENEWALS / SURVEYS, ETC.

SURVEYED IN 1860 BY MAXON AND HURD UNDER CONTRACT #50, THEY SET POST AND MADE MOUND.
IN 1984 LS 951 SET 1/2" IRON ROD OVER 1" BOLT.
IN 1990 LS 951 SET 2 1/2" BRASS CAP IN CONCRETE OVER BOLT.

MONUMENTS AND ACCESSORIES FOUND: CONDITION AND SOURCE

FOUND 2 1/2" BRASS CAP STAMPED AS BELOW.
FOUND 5/8" IRON ROD WITH YELLOW PLASTIC CAP STAMPED LS 951 BEARS S 70°48'32" E, 63.87'.
FOUND 5/8" IRON ROD WITH YELLOW PLASTIC CAP STAMPED LS 951 BEARS S 52°21'17" W, 31.57'.
FOUND ALUMINUM TAG IN POWER POLE STAMPED LS 951 BEARS S 42°40'57" W, 26.91'.
FOUND ALUMINUM TAG IN RAIL ROAD TIE STAMPED LS 951 BEARS NW, +/- 30'. (RAIL ROAD TIE LEANING, DO NOT USE)

MONUMENT DETAIL

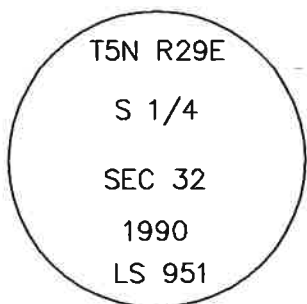

NAD 83/91
OREGON STATE PLANE
INTERNATIONAL FEET

803859.22
8529835.21

MONUMENT SET (PROCEDURES AND DESCRIPTION)

NEW ACCESSORIES FROM WHICH

SET 5/8" X 30" IRON ROD WITH YELLOW PLASTIC CAP STAMPED PLS LS 48509 BEARS N 22°20'44" W, 50.37'.

LOCATION AND COMMENTS

CORNER FALLS AT THE INTERSECTION
OF PUNKIN CENTER ROAD AND
CABANA ROAD.

FIRM/AGENCY

PRIMM LAND SURVEYING, INC.
P.O. BOX 1322
HERMISTON, OREGON 97838

LAND SURVEYOR

BRIT L. PRIMM

WITNESS

KEITH P. PRIMM

SURVEYOR'S SEAL

REGISTERED
PROFESSIONAL
LAND SURVEYOR

OREGON
JULY 13, 1999
BRIT L. PRIMM
48509

EXPIRATION DATE: 12/31/24