

OREGON CORNER RESTORATION FORM

COUNTY: Umatilla. DATE: 12/17/19.

CORNER DESIGNATION: P-9, The East 1/4 corner of Section 20, Township 5 North, Range 31 East, W.M.

PREVIOUS RENEWALS/SURVEYS ETC: Corner was originally established by Nicholus O. Walden, Deputy Surveyor, under Contract No. 209, dated July 6, 1874. Notes state: Drove charred stake and raised mound of earth with pits etc., as per instructions for 1/4 Sec. Corner.

MONUMENT AND ACCESSORIES FOUND: None. Held fence corner at intersection of rebuilt fence extending North and South and old fence extending East as best remaining evidence of the original corner point.

MONUMENT MARKING DETAIL:

T5N R31E	NAD 83 (2011) epoch 2010.00 Coordinates
1/4	International feet units:
S20 S21	N: 817823.31
2019	E: 8595680.65
PLS 1106	

MONUMENT SET: At the West edge of a railroad tie fence corner, set a 2 1/2" brass cap on 1 1/4 by 30" galvanized iron pipe 28" in the ground. Cap is marked as shown in "Monument Marking Detail".

New accessories:

- A 5/8 by 24" rebar with 1 1/4" red plastic cap bears N 00°41' W, 55.06'.
- A 5/8 by 24" rebar with 1 1/4" red plastic cap bears N 00°15' W, 23.20'.
- A 5/8 by 24" rebar with 1 1/4" red plastic cap bears S 00°26' E, 19.63'.
- A 5/8 by 24" rebar with 1 1/4" red plastic cap bears S 00°06' E, 43.07'.

Bearings reported to accessories are State Plane Grid bearings.


Red plastic caps are marked "ORPLS 1106 WAPLS 17372". Rebar accessories have "bearing object" signs wired to them. The rebar accessories are set approximately 1/2 foot West of a North-South fence line.

Nailed a "Witness" sign to railroad tie fence corner just East of corner monument.


LOCATION AND COMMENTS: Corner is located on a ridge top at fence corner with fences extending North-South and East. Reference survey: Property Line Adjustment for Thorne and Rupp, Sections 17, 20 and 29, T5N., R31E., W.M. PLA Application/Map submitted 12-19.

FIRM: Wells Surveying
P.O. Box 1696
Pendleton, OR 97801

Surveyor's Seal

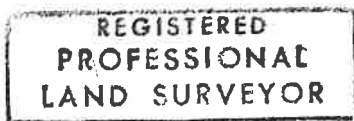

William R. Wells

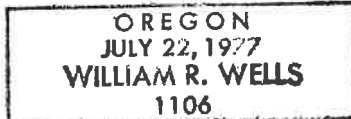

renews 6-30-20

\5N31P-9