

OREGON CORNER RESTORATION FORM

Section 9 Township 5N Range 34E
 County Umatilla Date: June 12, 2003

Corner Designation: 5N34G13

Common quarter corner to sections 9 and 10, T5N, R34E, W.M., Umatilla County, Oregon.


Condition Report Only
 Not found
x Remonumented
 Unrecorded
 Surveyed in
x Referenced out

Previous Renewals / Surveys, etc.

Corner originally set by Wm. H. Odell and Wm. S. Lewis. under contract No. 110 dated February 7th, 1865. Their record reads: Set 1/4 sec. post; drove charred stake; dug pits and raised mound as per instructions. Under the survey recorded in Book 1 at Page 400 of the Record of Private Surveys, John Kimbrell calls "set stone 16 x 11 x 9. In the survey recorded in Book 1, Page 466 C.E. Macomber calls "set stone for 1/4 Sec. Cor. 15 x 10 x 10". In the survey recorded in Book 2, Page 276, Willard Bradley calls "set large egg shaped stone for 1/4 Cor. marked 1/4".

Monument and Accessories found: (condition and source)

A basalt stone 20" x 16" x 13" with an "x" on top and 1/4 on the S. face set by Bradley. It was under the existing fence and was firmly in place. It is egg shaped.

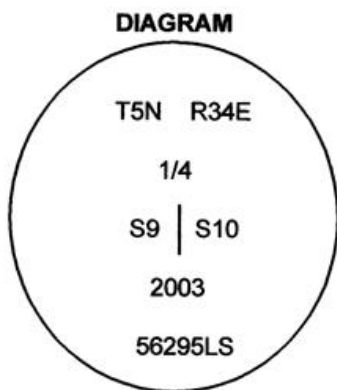

A hand-drawn sketch of a fence line. A north arrow is at the top left. The word 'Plowed' is written above the fence. A legend indicates that a circle with a dot represents a 'Brass cap' and a solid dot represents an 'Iron rebar reference'. The sketch shows a fence line with several 'x' marks representing posts. One post has a circle with a dot (brass cap) attached to it. A note says 'Attached a monument sign to the fence by the corner.' To the right of the fence, a large stone is shown under the fence, with a note 'large stone under the fence 30" x 22" x 18" above ground.' Below the fence, the word 'Grazing' is written.

MONUMENT (S) AND ACCESSORIES SET (Procedures and Description)

I set a 1 1/2" x 30" galvanized iron pipe with a 2 1/4" brass cap stamped as shown in the diagram above at the position of the stone. I attached a County monument sign to a post in the existing fence. I buried the stone on the west side of the brass cap.

For references, I set four 5/8" by 24" green coated iron rebars with 1 1/8" orange plastic caps stamped WTS and 56295LS as described below:

- a rebar bears N86°21'44"W, 46.04' feet under the existing fence;
- a rebar bears N86°59'57"W, 21.72 feet under the existing fence;
- a rebar bears S82°44'20"E, 42.09 feet near a stone, 30 x 22 x 18 ins., at the existing fence corner;
- a rebar bears S63°59'54"E, 59.93 feet under the existing fence;

The monument and references were tied using a LIECA system 300 RTK GPS.

Location and comments
 NAD 83-91 coordinates from a single
 GPS tie to tri station GEER.

N 829515.39
 E 8696018.79
 RECEIVED BY:
Umatilla County Surveyor

Date: 10-03
 Rec'd By: KK
 No. 03-314C

Compass Declination
 Firm / Agency
 Witness Tree Surveying
 Address
 P.O. Box G
 Pilot Rock, Or. 97868
 Party Chief
 Stephen K, Haddock

Surveyors Seal

REGISTERED
 PROFESSIONAL
 LAND SURVEYOR

Stephen K. Haddock

OREGON
 JULY 9, 2001
 STEPHEN K. HADDOCK
 56295LS

RENEWAL DATE 6-30-05