

**OREGON CORNER RESTORATION FORM**

Section 8 Township 5N Range 34E  
 County Umatilla Date: March 12, 2003

Corner Designation: 5N34G9

Common quarter corner to sections 8 and 9, T5N, R34E, W.M., Umatilla County, Oregon.


Condition Report Only  
 Not found  
x Remonumented  
 Unrecorded  
 Surveyed in  
x Referenced out

Previous Renewals / Surveys, etc.

Corner originally set by Wm. H. Odell and Wm. S. Lewis. under contract No. 110 dated February 7th, 1865. Their record reads: Set 1/4 sec. post in ravine, drove charred stake; dug pits and raised mound as per instructions. Under the survey recorded in Book 2 at Page 310 of the Record of Private Surveys, Aubrey Perry calls "set rock, drive stake and make mound of rock".

Monument and Accessories found: ( condition and source )

A basalt stone 20" x 8" x 7" with an "x" on top in a mound of stone. The decayed remains of a wooden stake were in place on the north side of the stone.

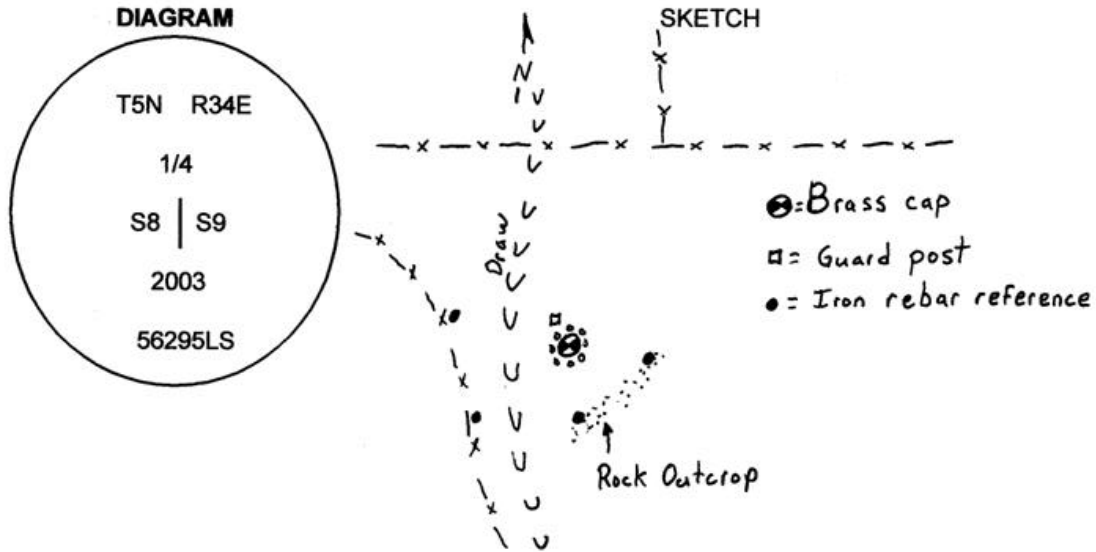

**MONUMENT (S) AND ACCESSORIES SET (Procedures and Description)**

I set a 1 1/2" x 30" galvanized iron pipe with a 2 1/4" brass cap stamped as shown in the diagram above at the position of the stone in the existing mound. I set a 5" steel guard post with a County monument sign attached along side. I buried the stone at the side of the brass cap.

For references, I set four 5/8" by 24" green coated iron rebars with 1 1/8" orange plastic caps stamped WTS and 56295LS as described below:

- a rebar bears N88°24'19"W, 53.97' feet under the existing fence;
- a rebar bears S46°05'25"W, 52.34 feet under the existing fence;
- a rebar bears S7°46'40"E, 46.64 feet in a small rock outcrop;
- a rebar bears S50°55'52"E, 29.56 feet in a small rock outcrop;

The monument and references were tied using a LIECA system 300 RTK GPS.

Location and comments  
 NAD 83-91 coordinates from a single  
 GPS tie to tri station GEER.

N 829466.50  
 E 8690621.93  
 RECEIVED BY:  
Umatilla County Surveyor  
 Date: 10-03  
 Rec'd By: KK  
 No. 03-3131C

Compass Declination  
 Firm / Agency  
 Witness Tree Surveying  
 Address  
 P.O. Box G  
 Pilot Rock, Or. 97868  
 Party Chief  
 Stephen K, Haddock

Surveyors Seal

REGISTERED  
 PROFESSIONAL  
 LAND SURVEYOR

*Stephen K. Haddock*

OREGON  
 JULY 9, 2001  
 STEPHEN K. HADDOCK  
 56295LS

RENEWAL DATE 6-30-05