

**OREGON CORNER RESTORATION FORM**

Section 9 Township 5N Range 34E  
 County Umatilla Date: March 10, 2003

Corner Designation: 5N34J13

Corner to sections 9, 10, 15, and 16, T5N, R34E,  
 W.M., Umatilla County, Oregon.

Condition Report Only  
 Not found  
x Remonumented  
 Unrecorded  
 Surveyed in  
x Referenced out



State Plane Coordinates, Oregon North, 83(1991) based on a  
 single GPS tie to Tri Station GEER, N = 826940.46 E = 8696173.91

Previous Renewals / Surveys, etc.

Corner originally set by Wm. H. Odell & Wm. S. Lewis under contract No. 110 dated February 7th, 1865. Their record reads: Set post Cor. for Secs. 9, 10, 15, & 16. Drove Charred Stake; dug pit and raised mound, as per instructions. L. E. Macomber in the survey in Book 1, Page 466 of the record of private surveys said "I exhumed the old charred stake. I planted a stone 18 x 12 x 12. Willard Bradley in the survey in Book 2, Page 276 of the record of private surveys says "a stone with an x, fence N & S". Aubrey Perry in the survey in Book 2, Page 310 says "to a rock marked x on N & S fence.

Monument and Accessories found: ( condition and source )

A basalt stone 18" x 13" x 12" marked "x" on top at a fence corner with fences North and East.

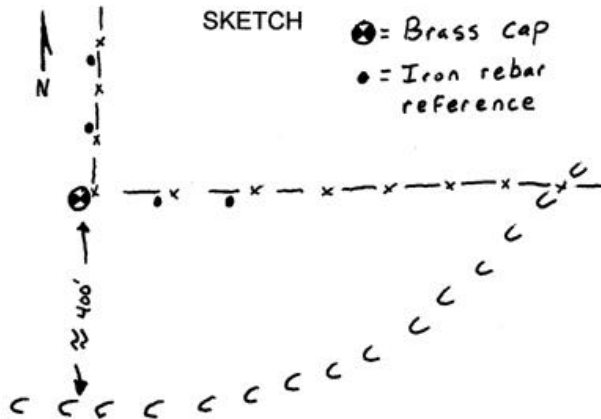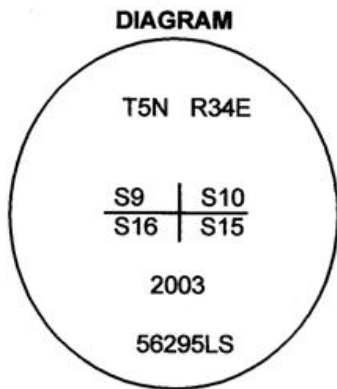

**MONUMENT (S) AND ACCESSORIES SET (Procedures and Description)**

I set a 1 1/2" x 30" galvanized iron pipe with a 2 1/4" brass cap stamped as shown in the diagram above at the position of the stone. I attached a County Monument sign to the fence corner post. I buried the stone along side.

For references, I set four, 5/8" by 24" green coated iron rebars with 1.25" orange plastic caps stamped WTS and 56295LS as described below:

- a rebar bears N1°28'17"W, 55.94 feet;
- a rebar bears N1°09'42"W, 25.08 feet;
- a rebar bears N89°41'21"E, 16.92 feet;
- a rebar bears S89°54'33"E, 38.31 feet;

The monument and references were tied using a LIECA system 300 RTK GPS.

Location and comments

Compass Declination

Surveyors Seal

RECEIVED BY:  
 Umatilla County Surveyor  
 Date: 10-03  
 Rec'd By: KR  
 No. 03-317C

Firm / Agency  
 Witness Tree Surveying  
 Address  
 P.O. Box G  
 Pilot Rock, Or. 97868  
 Party Chief  
 Stephen K, Haddock

REGISTERED  
 PROFESSIONAL  
 LAND SURVEYOR

*Stephen K. Haddock*

OREGON  
 JULY 9, 2001  
 STEPHEN K. HADDOCK  
 56295LS

RENEWAL DATE 6-30-05