

**OREGON CORNER RESTORATION FORM**

Section 19

Township 5N

Range 35E

County Umatilla

Date: 01/15/10

Corner Designation: 5N35N1

Corner common to sections 18,19 T5NR35E, 13,24, T5NRE.34E.

_____	Condition Report Only
<u>  X  </u>	Not Found
_____	Remonumented
_____	Unrecorded
<u>  X  </u>	Surveyed In
<u>  X  </u>	Referenced Out


**Previous Renewals / Surveys, etc.**

Surveyed by Wm. H. Odell & Wm. S. Lewis under Contract No. 110, dated February 7th 1865.


**Monuments and Accessories Found: (Condition and Source)**

None.

Diagram

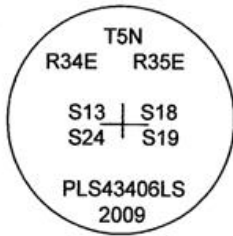

Sketch

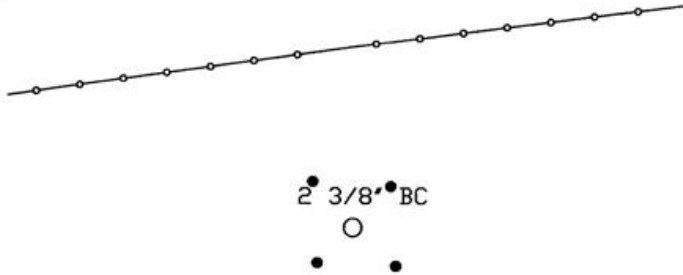

NAD 83/91  
OREGON STATE PLANE NORTH  
INTERNATIONAL FEET

N822071.30  
E8712151.71  
LAT - 45° 54' 14.88449" N  
LON - 118° 29' 46.57307" W

**Monument (s) Set (Procedures and Description)**

Set a 1 1/2" Galvanized Iron pipe w/ a 2 1/2" Brass Cap Stamped as shown.  
A magnet 16" deep lies N 17° W, 12.77'  
A magnet 16" deep lies N 67°30 E, 11.26'  
A magnet 16" deep lies S 30° E, 10.35'.  
A magnet 15" deep lies S 54°30' W, 11.58'.

**References Set:**

None

**Location and Comments**

From the intersection of Gerking Flat Road and Sanders Road go East on Sanders Road until you reach a private gate where there is a Grain Silo. The corner is approx. .5 miles East from there, along the fence.

**Compass Declination**  
17° E

**Surveyors Seal**

REGISTERED PROFESSIONAL LAND SURVEYOR
---

*Robert D. English*  
 OREGON  
 JANUARY 11, 2005  
 ROBERT DOUGLAS ENGLISH  
 43406LS

RENEWAL DATE: 12/31/11
------------------------

**RECEIVED BY:**

Date: 12-09  
Rec'd By: \_\_\_\_\_  
No. 09-176-B

**Firm / Agency**

Survey One, LLC.  
P.O. Box 382  
Pendleton, OR 97801  
(541) 276-2055