

OREGON CORNER RESTORATION FORM

COUNTY: Umatilla. DATE: 10/07/21.

CORNER DESIGNATION: Z-11, Standard South 1/4 Corner, Section 33 only, Township 5 North, Range 34 East, W.M.

PREVIOUS RENEWALS/SURVEYS ETC: Corner was originally established by Odell and Lewis, Deputy Surveyors, under Contract No. 110, dated February 7, 1865. Notes state:

Set post for Standard Corner for 1/4 Sec., dug pits and raised mound and drove charred stake, as per instructions.

The May, 1929 County Road Map for Gerking Flat Road, Constructed Line, shows a tie from the centerline of the road to the corner. The corner monument is unidentified. The County Road Map shows the corner 102.4 feet East of Road centerline. I measure 105.14 feet East of existing road centerline.

MONUMENT AND ACCESSORIES FOUND: None. I reestablish the corner point at the projected intersection of a fence extending West and a distinct field line extending North for 1 mile. The fence line is West of Gerking Flat Road, extending from the Road to the top of the ridge above the road. Dave Cannon states he rebuilt this fence some years ago at the same location of an older fence. There is an old locust post North, 22 feet from the reestablished corner point and also a crooked field line extending East.

MONUMENT MARKING DETAIL:

SC
T5N R34E
1/4 S33

2021
PLS 1106

MONUMENT SET: Set a 2 1/2 inch brass cap on 1 1/4 inch galvanized iron pipe 28 inches in the ground. Cap marked as shown in Monument Marking Detail. Set a steel fence post with "Witness" sign wired to it 1 foot East of corner monument.

New accessories:

A 5/8 by 24 inch rebar bears N 01°36' W, 20.67 feet, with 1 1/4 inch red plastic cap. The rebar is 8 inches South of a locust post. Nailed "Bearing Object" sign to locust post.

A 5/8 by 24 inch rebar bears S 09°13' W, 132.96 feet, with 1 1/4 inch red plastic cap. The rebar is 2 feet West of a power pole. Nailed "Bearing Object" sign to the power pole.

A 5/8 by 24 inch rebar bears N 82°06' W, 93.95 feet, with 1 1/4 inch red plastic cap. The rebar is S 32° E, 10 feet from the East end of a 24 inch culvert crossing Gerking Flat Road. Wired "Bearing Object" sign to the rebar.


A 5/8 by 24 inch rebar bears N 46°46' W, 157.02 feet, with 1 1/4 inch red plastic cap. The rebar is 8 inches South of sawed off power pole beside a telephone pedestal. Nailed "Bearing Object" sign to the sawn power pole.

Red plastic caps are marked "ORPLS 1106 WAPLS 17372". Bearings and distances to accessories are State Plane Grid bearings and distances.


LOCATION AND COMMENTS: Corner is located 105 feet East of Gerking Flat Road at corner of fields.

FIRM: Wells Surveying
P.O. Box 1696
Pendleton, OR 97801

Surveyor's Seal

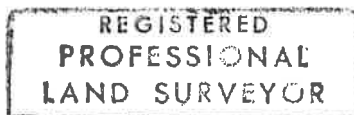

William R. Wells

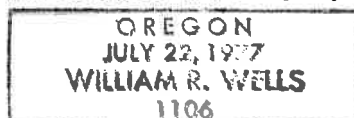

renews 6-30-22

\5N34Z-11

*PP/lat 2021-35
21-138-B*