

OREGON CORNER RESTORATION FORM

Section 1 Township 5N Range 36E
 County Umatilla Date: May 12, 2012

Corner Designation: 5N36E25

Condition Report Only
 Not found
 x Remonumented
 Unrecorded
 x Surveyed in
 x Referenced out


Corner common to sections 1 and 12, R36E and sections 6 and 7 of R37E, T5N, W.M., Umatilla County, Oregon.

Previous Renewals / Surveys, etc.

Corner was originally set by Odell and Lewis under contract No. 110 dated February 7, 1865. Their record reads: Set post cor. for secs. 1, 12, 6 & 7, on hillside facing E., drove charred stake dug pits & raised mound, as per instructions. John Kimbrell, in the Record of Private Surveys Book 1, Page 374, (Survey 99) adopted the existing fence corner as the best available evidence.


Monument and Accessories found: (condition and source)
 None. The point falls in a farmed field on a steep east facing hillside.

DIAGRAM

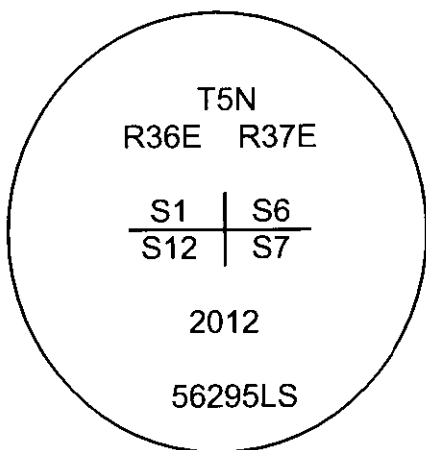

⊙ = Brass cap.
 • = Rebar reference.

SKETCH

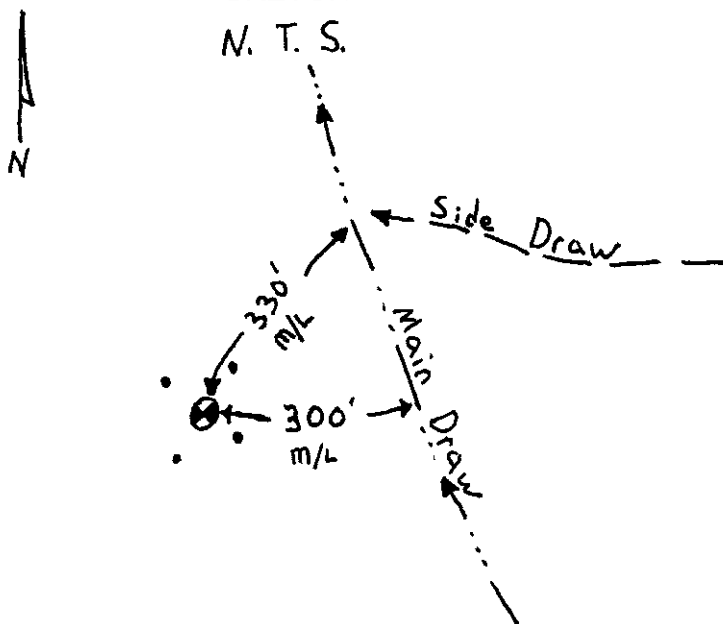

MONUMENT (S) AND ACCESSORIES SET (Procedures and Description)

I set a 2 3/8" brass cap on a 1 1/2"x30" galvanized iron pipe with a brass cap stamped as shown in the diagram above 2 feet below the surface of the field at the proportionate point.

For references: I set 4, 5/8"x24" iron rebars with orange plastic caps stamped WTS and 56295LS as described below 2 feet below the surface of the field.

- An iron rebar bears S26°38'54"W, 20.35 feet;
- An iron rebar bears N55°44'18"W, 24.63 feet;
- An iron rebar bears N29°05'42"E, 21.88 feet;
- An iron rebar bears S63°03'24"E, 21.12 feet;

The monument and references were tied using a Trimble R7/R8 RTK GPS system.

Location and comments
 NAD 83/1991 State Plane Coordinate
 Oregon North Zone
 N = 834449.87 ift
 E = 8775226.01 ift

Compass Declination

Surveyors Seal

Firm / Agency
 Witness Tree Surveying
 Address
 P.O. Box G
 Pilot Rock, Or. 97868
 Party Chief
 Stephen K, Haddock

**REGISTERED
 PROFESSIONAL
 LAND SURVEYOR**

Stephen K. Haddock

**OREGON
 JULY 9, 2001
 STEPHEN K. HADDOCK
 56295LS**

RENEWAL DATE 6-30-13

RECEIVED BY:

Umatilla County Surveyor
 Date: 6/5/2012
 Rec'd By: S. Ous
 No. 12-088-C