

OREGON CORNER RESTORATION FORM

Section 5 Township 5N Range 36E
 County Umatilla Date: July 16, 2012

Corner Designation: 5N36E7

Condition Report Only
 Not found
 Remonumented
 Unrecorded
 Surveyed in
 Referenced out


Quarter corner common to sections 5 and 8,
 T5N, R36E, W.M., Umatilla County, Oregon.

Previous Renewals / Surveys, etc.

Corner originally set by Odell and Lewis under contract No. 110 dated February 7, 1865. Their record reads: Set 1/4 Sec. post, drove charred stake, dug pits and raised mound, as per instructions. John Kimbrell, in the record of private surveys Book 1, Page 393, reports finding particles of the decayed post which he sealed in a glass fruit jar and bury 2 feet below the surface with 1 quart of stone coal. He then set a stone 26x10x9 inches.


Monument and Accessories found: (condition and source)
 None. The point falls in a farmed CRP field.

DIAGRAM

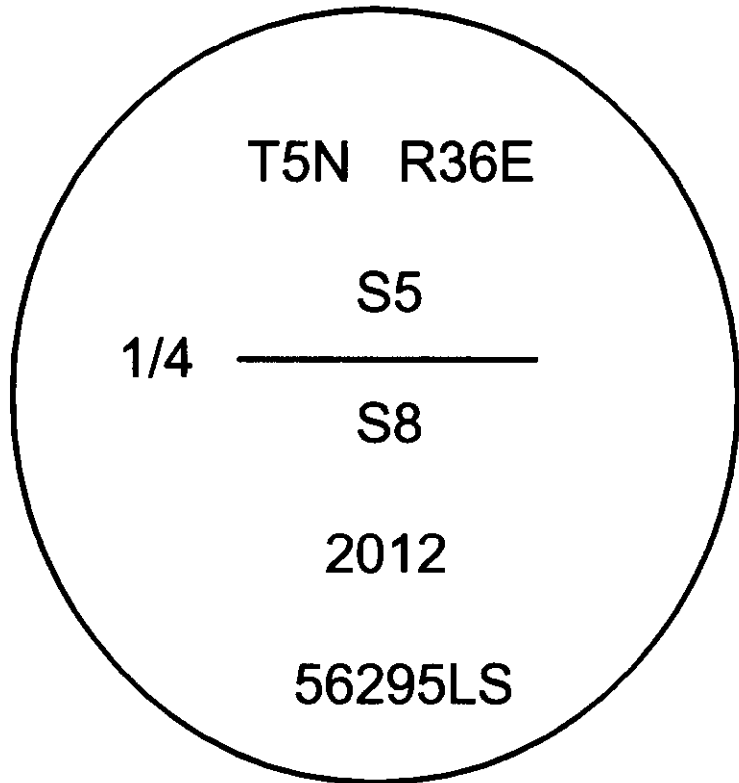

⊗ = Brass Cap
 • = Rebar Reference

SKETCH

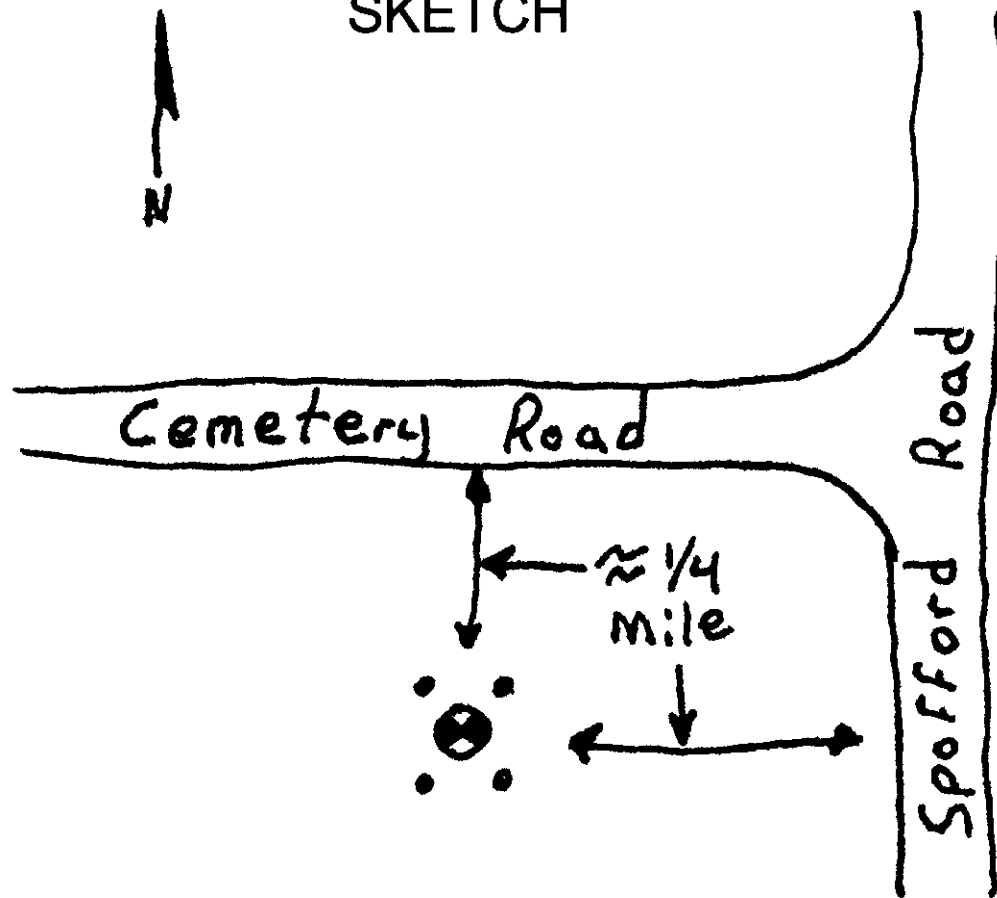

MONUMENT (S) AND ACCESSORIES SET (Procedures and Description)

At the point calculated by the broken boundary method, I set a 2 3/8" brass cap on a 1 1/2" x 30" galvanized iron pipe stamped as shown in the diagram above 24" below the surface of the farmed field.

For references, I set four 5/8" by 24" iron rebars with 1 1/4" orange plastic caps stamped WTS and 56295LS as described below 20" below the surface:

- an iron rebar bears S39°13'45"W, 24.02 feet;
- an iron rebar bears N44°19'42"W, 28.57 feet;
- an iron rebar bears N42°28'02"E, 27.46 feet;
- an iron rebar bears S46°04'46"E, 26.56 feet;

The monument was set and references tied using a Trimble R7/R8 RTK GPS system.

Location and comments
 NAD 83/1991 State Plane Coordinate
 Oregon North Zone
 N = 833537.23 ift
 E = 8751812.90 ift

Compass Declination

Surveyors Seal

RECEIVED BY:
Umatilla County Surveyor
 Date: 12/6/2012
 Rec'd By: [Signature]
 No. 12-155-B

Firm / Agency
 Witness Tree Surveying
 Address
 P.O. Box G
 Pilot Rock, Or. 97868
 Party Chief
 Stephen K, Haddock

REGISTERED
 PROFESSIONAL
 LAND SURVEYOR

Stephen K. Haddock

OREGON
 JULY 9, 2001
 STEPHEN K. HADDOCK
 56295LS

RENEWAL DATE 6-30-13