

OREGON CORNER RESTORATION FORM

Section 4 Township 5N Range 36E
 County Umatilla Date: June 22, 2012

Corner Designation: 5N36E9


Corner common to sections 4, 5, 8, and 9,
 T5N, R36E, W.M., Umatilla County, Oregon.

Condition Report Only
 Not found
 Remonumented
 Unrecorded
 Surveyed in
 Referenced out


Previous Renewals / Surveys, etc.

Corner was originally set by Odell and Lewis under contract No. 110 dated February 7, 1865. Their record reads: Set post corner for secs. 4, 5, 8 and 9. Drove charred stake, dug pits, raised mound, as per instructions. In the record of Private Surveys Book 1, Page 393 (survey No. 100) John Kimbrell reports finding particles of old charred stake. He enclosed some of the stake in a small square glass bottle which he burried along with 1 quart of stone coal 2 feet below the surface. He then set a stone 22x12x10 with 5 notches on the S. and 4 notches on the E. edges.

Monument and Accessories found: (condition and source)
 None. This point falls in a north - south field road.

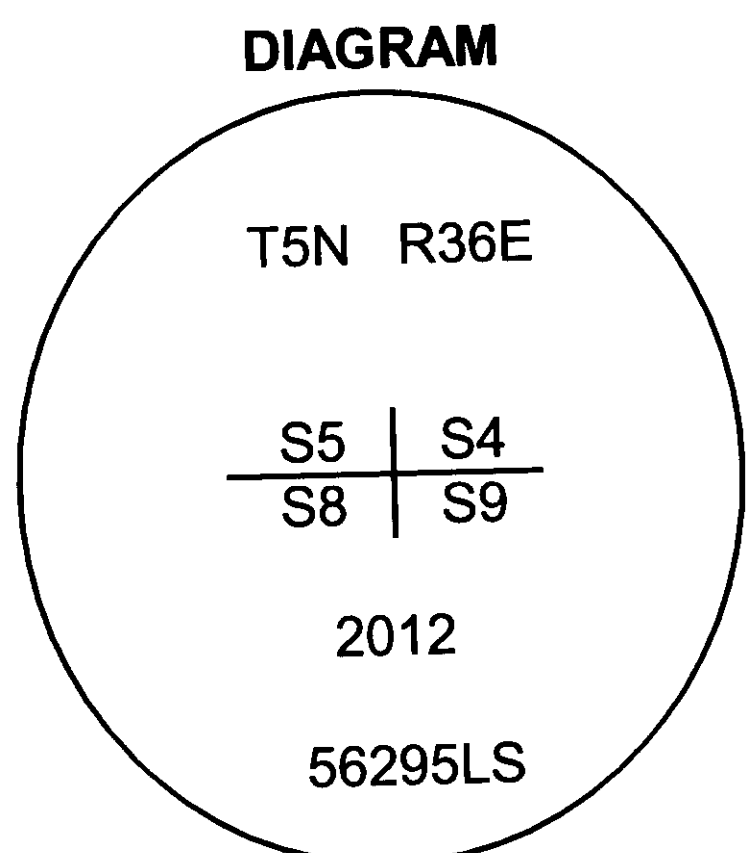

⊙ = Brass Cap
 • = Rebar Reference

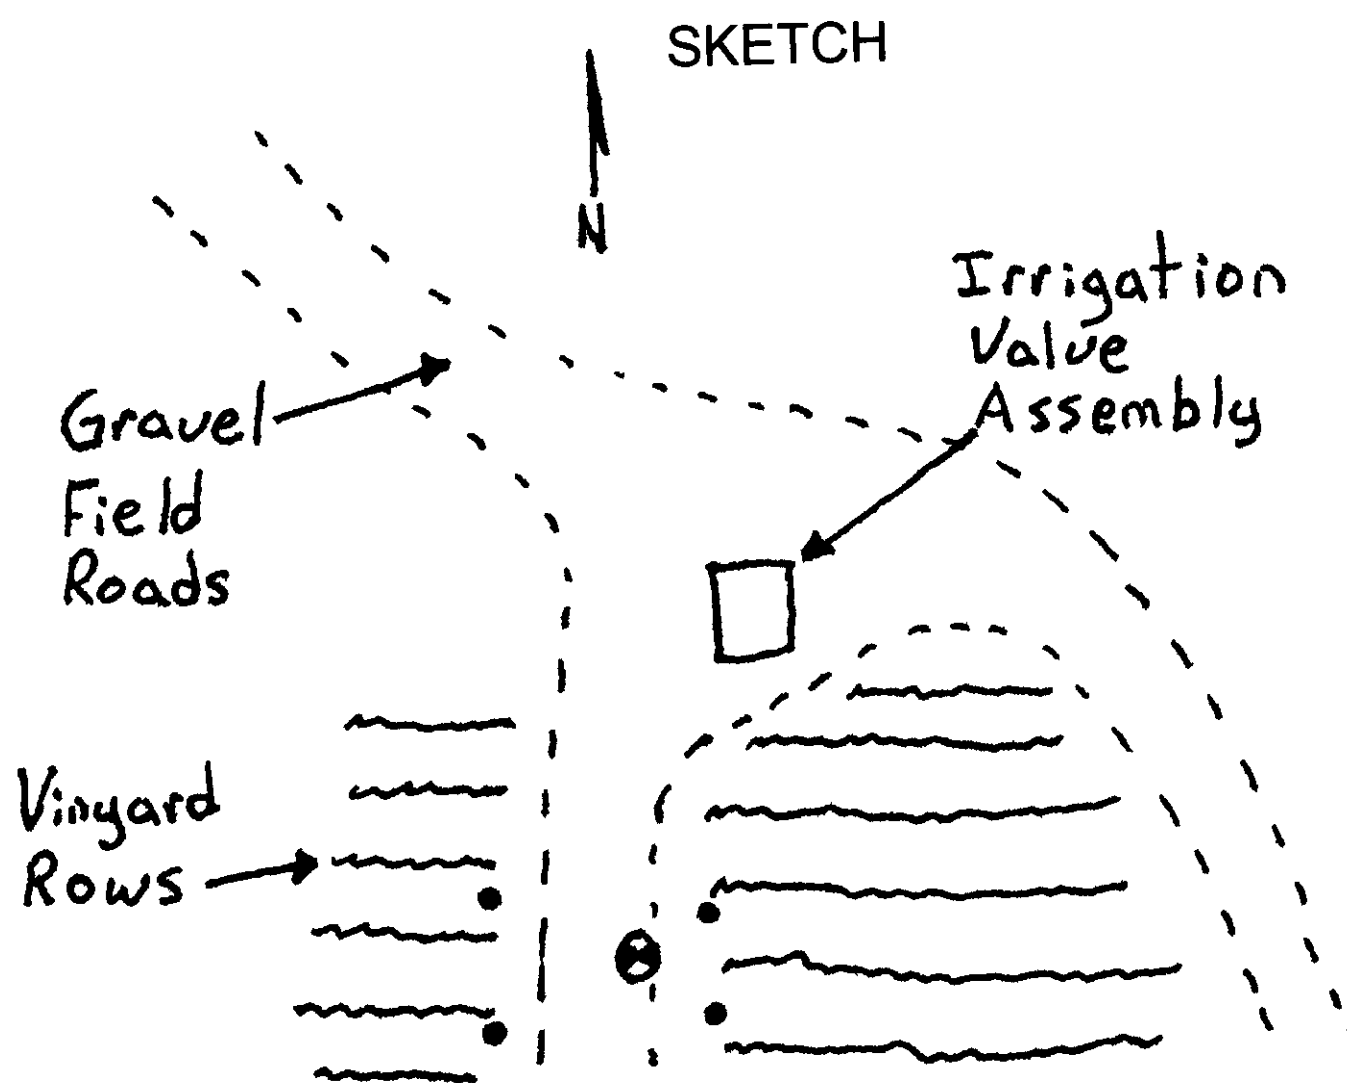

MONUMENT (S) AND ACCESSORIES SET (Procedures and Description)

I set a 2 3/8" brass cap on a 1 1/2"x30" galvanized iron pipe with a brass cap stamped as shown in the diagram above at the intersection of the projected south and west lines of Section 4.

For references: I set 4, 5/8"x24" iron rebars with orange plastic caps stamped WTS and 56295LS as described below:

- An iron rebar bears S51°05'19"W, 19.05 feet;
- An iron rebar bears N55°10'20"W, 18.17 feet;
- An iron rebar bears N34°29'19"E, 15.31 feet;
- An iron rebar bears S56°30'31"E, 13.37 feet;

The monument was set and references tied using a Trimble R7/R8 RTK GPS system.

Location and comments
 NAD 83/1991 State Plane Coordinate
 Oregon North Zone
 N = 833642.03 ift
 E = 8754478.59 ift

Compass Declination

Firm / Agency
 Witness Tree Surveying
 Address
 P.O. Box G
 Pilot Rock, Or. 97868
 Party Chief
 Stephen K, Haddock

Surveyors Seal

REGISTERED
 PROFESSIONAL
 LAND SURVEYOR

Stephen K. Haddock

OREGON
 JULY 9, 2001
 STEPHEN K. HADDOCK
 56295LS

RENEWAL DATE 6-30-13

RECEIVED BY:

Umatilla County Surveyor
 Date: 12/6/2012
 Rec'd By: S. Oles
 No. 12-155-B