

OREGON CORNER RESTORATION FORM

Section 7 Township 5N Range 36E
 County Umatilla Date: September 18, 2012

Corner Designation: 5N36G1

Condition Report Only
 Not found

x Remonumented

Unrecorded

Surveyed in

x Referenced out

Quarter corner common to section 12, T5N, R35E and section 7, T5N, R36E, W.M., Umatilla County, Oregon.


Previous Renewals / Surveys, etc.

Corner originally set by Deputy Surveyors Odell & Lewis under contract No. 110 dated February 7th, 1865. Their record reads: Set 1/4 sec. post, drove charred stake, dug pits & raised mound, as per instructions. In survey S-157-C Krumbein states: Hayes notes stone. In survey 83-010-B, 9: Krumbein states: set brass cap. In survey 95-78-B, Munns states: found rock with "x" 18" deep; In survey 01-155-B, Tomkins states: found rock with "+" 15" deep.

Monument and Accessories found: (condition and source)

A basalt stone, 24x18x12 with an "x" on top (painted pink) approximately 18" below the surface with a bent angle iron draw bar along side.


DIAGRAM

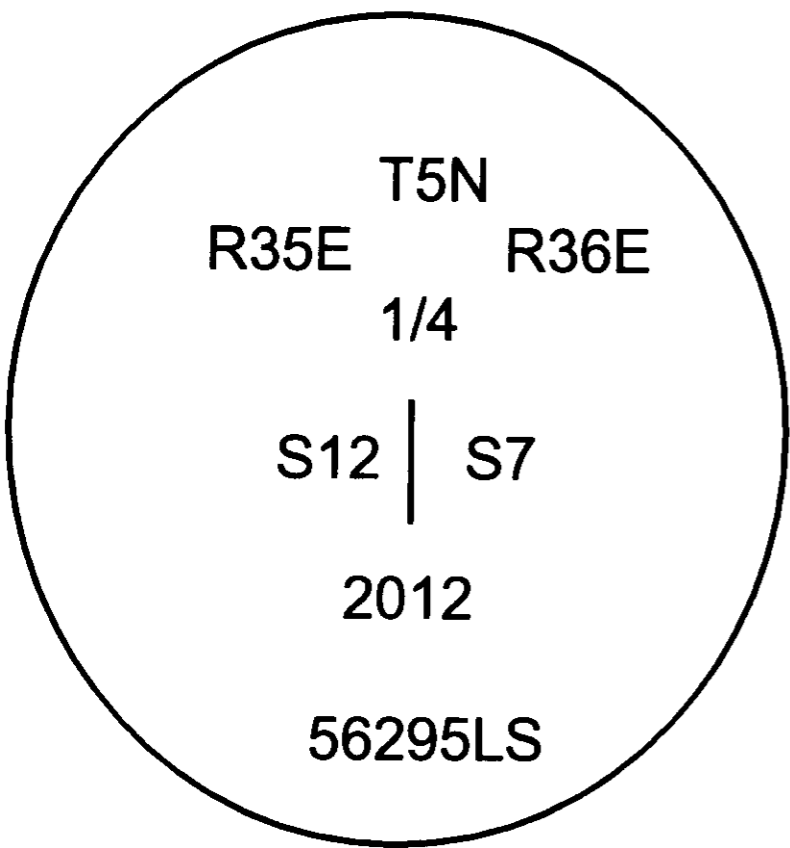

⊗ = Brass Cap

• = Rebar Reference

SKETCH

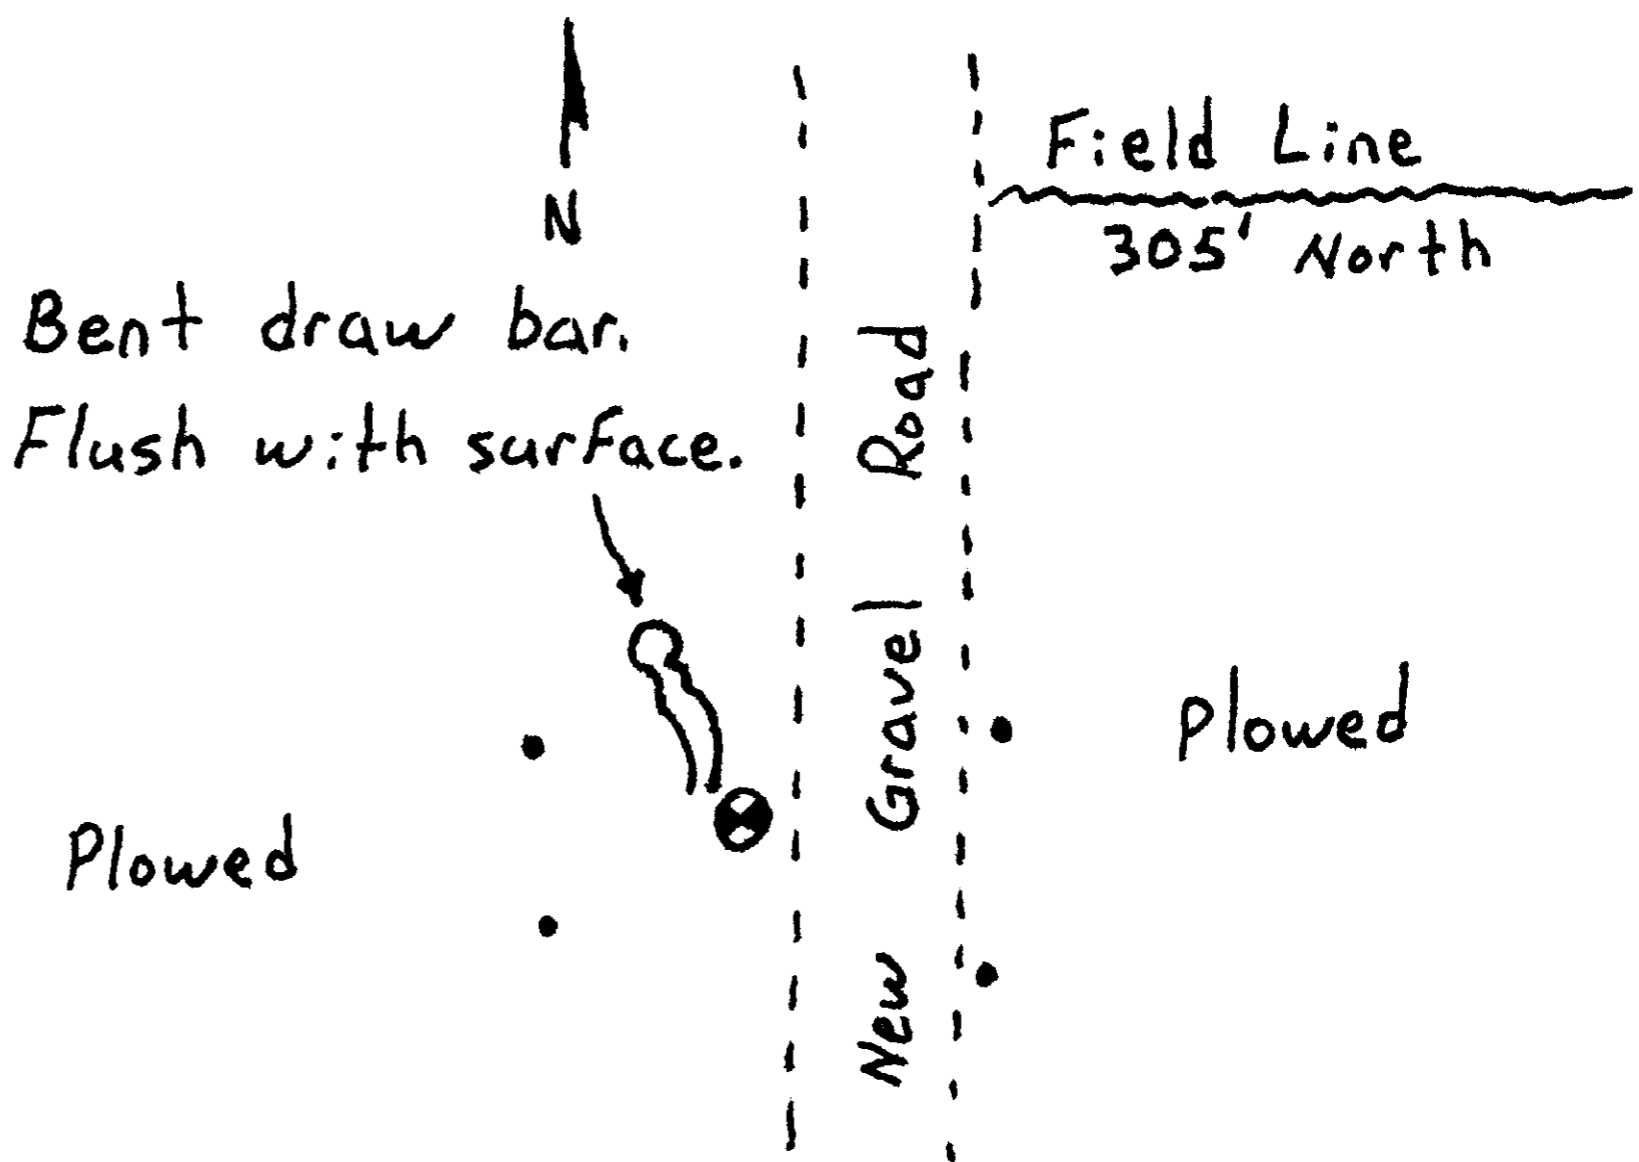

MONUMENT (S) AND ACCESSORIES SET (Procedures and Description)

At the position of the stone I set a 1 1/2" x 30" galvanized iron pipe with a 2 3/8" brass cap stamped as shown in the diagram above 18" below the surface of a plowed field on the west. edge of a new gravel road.

For references, I set four 5/8" by 24" iron rebars with 1 1/8" orange plastic caps stamped WTS and 56295LS 2 feet below the surface as described below:

a rebar bears N45°53'02"W, 27.06 feet;

a rebar bears N49°01'50"E, 26.78 feet;

a rebar bears S50°59'27"E, 25.98 feet;

a rebar bears S47°23'12"W, 27.72 feet;

The monument and references were tied using a Trimble R7/R8 RTK GPS system.

Location and comments
 NAD 83/1991 State Plane Coordinate
 Oregon North Zone
 N = 830398.84 ift
 E = 8743468.49 ift

Compass Declination

Surveyors Seal

RECEIVED BY:
 Umatilla County Surveyor
 Date: 12/6/2012
 Rec'd By: S. Ous
 No. 12-155-B

Firm / Agency
 Witness Tree Surveying
 Address
 P.O. Box G
 Pilot Rock, Or. 97868
 Party Chief
 Stephen K, Haddock

REGISTERED
 PROFESSIONAL
 LAND SURVEYOR

Stephen K. Haddock
 OREGON
 JULY 9, 2001
 STEPHEN K. HADDOCK
 56295LS

RENEWAL DATE 6-30-13