

OREGON CORNER RESTORATION FORM

Section 12 Township 5N Range 36E
 County Umatilla Date: March 3, 2012

Corner Designation: 5N36G25

Condition Report Only
 Not found
 Remonumented
 Unrecorded
 Surveyed in
 Referenced out

Quarter corner common to section 12, T5N, R36E, and section 7, T5N, R37E, W.M., Umatilla County, Oregon.


Previous Renewals / Surveys, etc.

Corner was originally set by Odell and Lewis under contract No. 110 dated February 7, 1865. Their record reads: Set 1/4 Sec. post, drove charred stake, dug pits, & raised mound as per instructions. In Record of Private Surveys Book 1, Page 374, John Kimbrell subdivided section 7. When running the E-W centerline he called for a point for the 1/4 corner but did not identify a monument.

Monument and Accessories found: (condition and source)


I found a basalt stone 14x4x6, unmarked but in place at a fence corner with fence remains to the east and north and a plow line to the south.

DIAGRAM

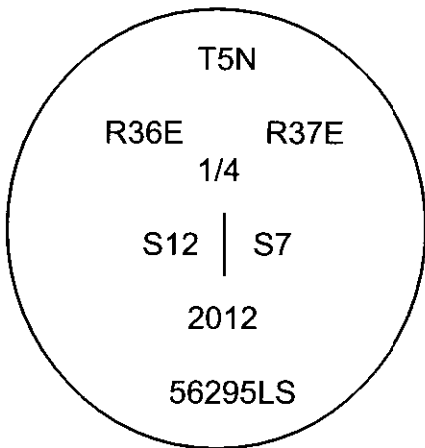

- ⊙ = Brass cap.
- = Rebar reference.
- = Wood guard post.

SKETCH

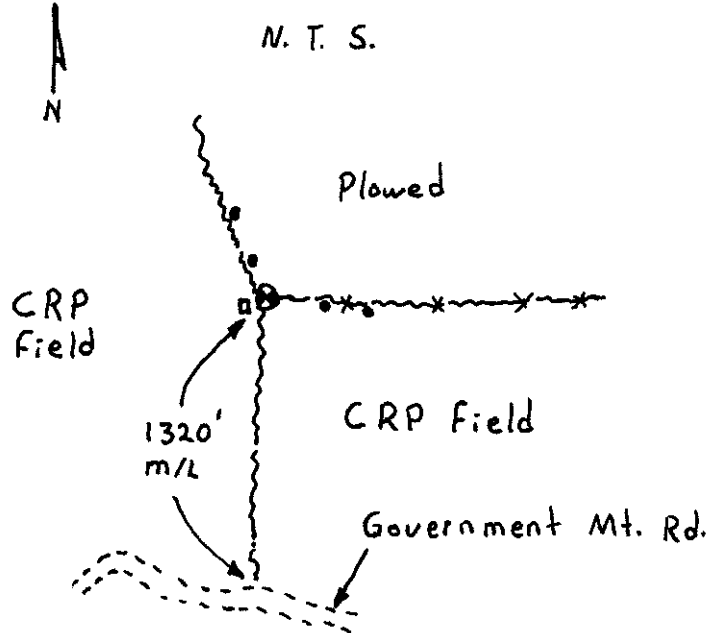

MONUMENT (S) AND ACCESSORIES SET (Procedures and Description)

At the position of the stone I set a 1 1/2" x 30" galvanized iron pipe with a 2 3/8" brass cap stamped as shown in the diagram above.

For references, I set four 5/8" by 24" iron rebars with 1 1/8" orange plastic caps stamped WTS and 56295LS as described below:

- an iron rebar bears N6°25'35"W, 27.00 feet;
- an iron rebar bears N4°12'11"W, 51.35 feet;
- an iron rebar bears S85°15'55"E, 25.04 feet;
- an iron rebar bears S88°23'48"E, 47.60 feet;

The monument and references were tied using Trimble R7/R8 RTK GPS.

Location and comments
 NAD 83/1991 State Plane Coordinate
 Oregon North Zone
 N = 831846.04 ift
 E = 8775226.43 ift

Compass Declination

Surveyors Seal

RECEIVED BY:

Umatilla County Surveyor
 Date: 6/5/2012
 Rec'd By: S. Res
 No. 12-088-C

Firm / Agency
 Witness Tree Surveying
 Address
 P.O. Box G
 Pilot Rock, Or. 97868
 Party Chief
 Stephen K, Haddock

**REGISTERED
 PROFESSIONAL
 LAND SURVEYOR**

Stephen K. Haddock

**OREGON
 JULY 9, 2001
 STEPHEN K. HADDOCK
 56295LS**

RENEWAL DATE 6-30-13