

**OREGON CORNER RESTORATION FORM**

Section 15 Township 5N Range 36E  
 County Umatilla Date: February 18, 2012

Corner Designation: 5N36J13

Corner common to sections 9, 10, 15, and 16,  
 T5N, R36E, W.M., Umatilla County, Oregon.

Condition Report Only  
 Not found  
 \_\_\_\_\_x Remonumented  
 Unrecorded  
 Surveyed in  
 \_\_\_ x \_\_\_ Referenced out


Previous Renewals / Surveys, etc.

Corner was originally set by Odell and Lewis under contract No. 110 dated February 7, 1865. Their record reads: Set post corner for secs. 9, 10, 15 and 16 on S. side of round butte. Drove charred stake, dug pits raised mound, as per instructions; John Kimbrell, in Survey No. 100 found original post in place in a mound of stones at the intersection of fences N-S-E & W".

Monument and Accessories found: ( condition and source )


The mound of stone at the fence corner with fences running east, west and south.

**DIAGRAM**

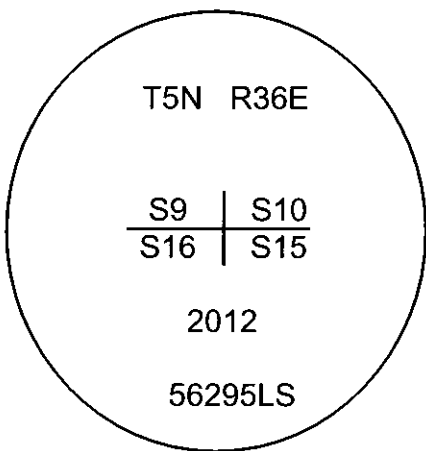

- ⊗ = 1" Iron Rebar.
- = 5/8" Rebar reference.

**SKETCH**

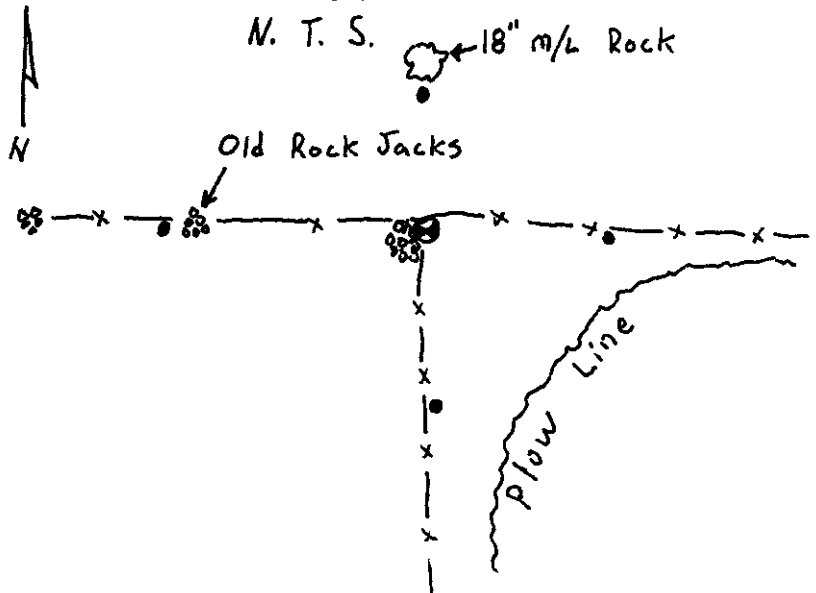

**MONUMENT (S) AND ACCESSORIES SET (Procedures and Description)**

At the corner point I set a 1" x 24" Iron Rebar with a 2" Al cap driven flush with the ground. The cap is stamped as shown in the diagram above.

For references: I set 4, 5/8"x24" iron rebars with orange plastic caps stamped WTS and 56295LS as described below:

- An iron rebar bears N86°36'09"E 33.20 feet under the existing fence;
- An iron rebar bears S7°13'45"E, 33.45 feet under the existing fence;
- An iron rebar bears S89°54'18"W, 34.87 in a rock jack from the remains of the old fence;
- An iron rebar bears N0°00'55"W, 30.56 feet;

The monument and references were tied using a Trimble R7/R8 RTK GPS system.

Location and comments  
 NAD 83/1991 State Plane Coordinate  
 Oregon North Zone  
 N = 828383.88 ift  
 E = 8759390.09 ift

Compass Declination  
 Firm / Agency  
 Witness Tree Surveying  
 Address  
 P.O. Box G  
 Pilot Rock, Or. 97868  
 Party Chief  
 Stephen K, Haddock

Surveyors Seal

RECEIVED BY:  
 Umatilla County Surveyor  
 Date: 6/5/2012  
 Rec'd By: A. Res  
 No. 12-088-c

REGISTERED  
 PROFESSIONAL  
 LAND SURVEYOR

*Stephen K. Haddock*

OREGON  
 JULY 9, 2001  
 STEPHEN K. HADDOCK  
 56295LS

RENEWAL DATE 6-30-13