

OREGON CORNER RESTORATION FORM

Section 13 Township 5N Range 36E
 County Umatilla Date: May 10, 2012

Corner Designation: 5N36L25

Condition Report Only
 Not found


Remonumented
 Unrecorded
 Surveyed in
 Referenced out

Quarter corner common to section 13, T5N, R36E and section 18, T5N, R37E, W.M., Umatilla County, Oregon.

Previous Renewals / Surveys, etc.


Corner originally set by Deputy Surveyors Odell & Lewis under contract No. 110 dated February 7th, 1865. Their record reads: Set 1/4 sec. post, drove charred stake, dug pits & raised mound, as per instructions. In the record of private surveys, Book 1, Page 374, (Survey 99), John Kimbrell states "set stake" at the proportionate point.

Monument and Accessories found: (condition and source)
 None.

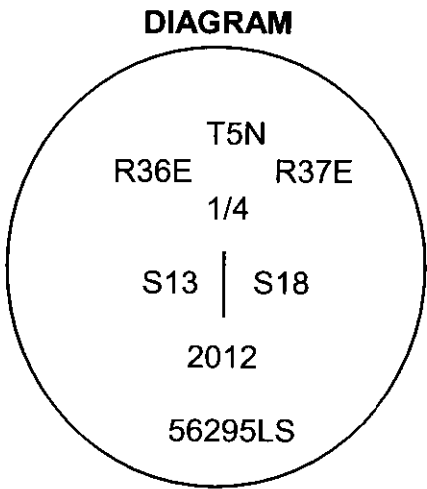

- = Brass cap.
- = Rebar reference.
- = Steel guard post.

SKETCH
 N. T. S.

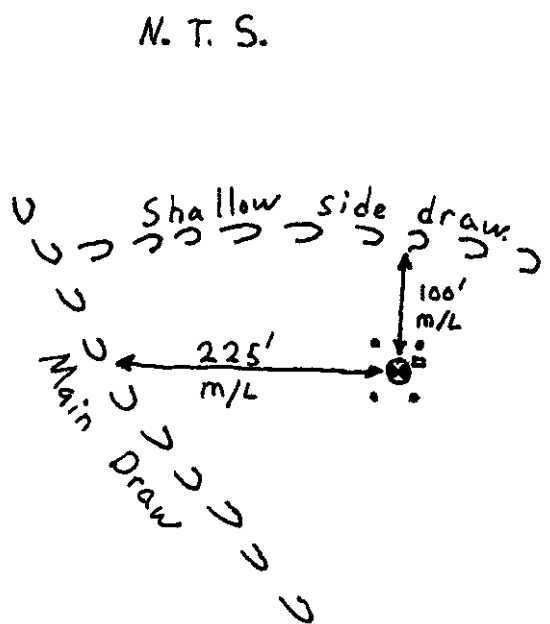

MONUMENT (S) AND ACCESSORIES SET (Procedures and Description)

At the proportionate point I set a 1 1/2" x 30" galvanized iron pipe with a 2 3/8" brass cap stamped as shown in the diagram above flush with the surface.

For references, I set four 5/8" by 24" iron rebars with 1 1/8" orange plastic caps stamped WTS and 56295LS as described below:

- a rebar bears N37°48'05"W, 20.90 feet;
- a rebar bears N55°29'09"E, 24.55 feet;
- a rebar bears S39°15'42"E, 22.61 feet;
- a rebar bears S33°07'38"W, 25.33 feet;

The monument and references were tied using a Trimble R7/R8 RTK GPS system.

Location and comments
 NAD 83/1991 State Plane Coordinate
 Oregon North Zone
 N = 826559.17 ift
 E = 8775336.02 ift

Compass Declination

Surveyors Seal

RECEIVED BY:
Umatilla County Surveyor
 Date: 6/5/2012
 Rec'd By: A. [Signature]
 No. 12-088-C

Firm / Agency
 Witness Tree Surveying
 Address
 P.O. Box G
 Pilot Rock, Or. 97868
 Party Chief
 Stephen K, Haddock

REGISTERED
 PROFESSIONAL
 LAND SURVEYOR

Stephen K. Haddock

OREGON
 JULY 9, 2001
 STEPHEN K. HADDOCK
 56295LS

RENEWAL DATE 6-30-13