

CERTIFIED RECORD OF LAND CORNER MONUMENTATION  
 Corner common to Townships 5 & 6 North,  
 Ranges 37 & 38 East,  
 of the Willamette Meridian.

A-25

## History of original corner establishment:

## General Land Office:

Mm. H. Odell & Mm. S. Lewis, Deputy Surveyors, Contract No. 110, dated 7 February, 1865.

"Set a post corner for Townships 5 & 6 North, Ranges 37 & 38 East, from which:

- A Fir 20 in. dia., bears N7°W, 23 lks.
- A Fir 20 in. dia., bears N18°E, 22 lks.
- A Fir 20 in. dia., bears S40°E, 18 lks.
- A Fir 10 in. dia., bears S23°W, 24 lks.

Geo. Williams, Deputy Surveyor, Contract No. 176, dated 20 July, 1872.

"Intersect town line, north boundary of Trns. 170 lks. west of Cor. for Trns. 5 & 6 N., R. 37 & 38 E."

## Description of evidence found:

June 23, 1956:

Bert Udell (notes taken off of an Aluminum location poster set by Udell on a 24 in. dia. Grand Fir, as these are the only record of his visit):

- "Ch. 2640 ft. South of good 1/4 corner
- Ch. 2632.5 ft. West of good 1/4 corner
- Ch. 2632.5 ft. East of old scribed stake in fence going west but I do not have notes.

No BT's, not chained south. There is an old knot with transit tack 5' north and 50' east with 3 old scarred BT' but not original. Don't know if record."

Udell set a tractor axle with an "X" stamped on the top of the tapered spindle at this point, which lies S64°E a distance of 9.0 feet from the tree bearing the location poster marked as noted.

The Bureau of Land Management ran a traverse line through this location within the last 5 years and dissected several of the larger Grand Firs in the vicinity but did not recover original evidence, nor set any monumentation.

## Description of monument and accessories I established to perpetuate the original location of this corner:

July 29, 1992:

Gregory A. Crites, Registered Professional Land Surveyor, Oregon No. 1887, and John Hopkins, headchairman:

Set 1-1/2" standard "Hoffland" galvanized iron pipe with 2-1/2" Bronze cap mkd. as shown on page 2, in mound of stone, from which:

The original 10" dia. Fir (now 44" dia.) (S23°W 24 lks.) bears S23°00'W 15.84 feet to original face with scribing. The B.L.M. dissected part of this tree and recovered a "cruisers mark" "T" of unknown origin in an upper face at a depth of 76 years, more or less. The B.L.M. dissected in all four quadrants of this tree, but found no other evidence. This live tree stands at the northwest corner of a barbed wire fence.

I dissected this tree to a depth of 127 years, more or less, by expanding the cuts made by the B.L.M. on the face pointing N23°E, and lowering my cut so that it would fall within 2 feet of the ground surface (the tree was only 10" dia. when originally marked, so I presumed the face would be close to the ground). We recovered the original marks at this point. No trace remains of the other 3 original bearing trees.

The tractor axle with "X" stamped on a tapered spindle as established by Bert Udell in 1956 lies N46°38'41"W a distance of 106.13 feet. (continued)

Office of \_\_\_\_\_ County of \_\_\_\_\_  
 State of \_\_\_\_\_, I hereby certify that the within instrument was  
 filed in this office for record on the \_\_\_\_\_ day of \_\_\_\_\_, 19\_\_\_\_  
 \_\_\_\_\_ by \_\_\_\_\_  
 (COUNTY OFFICIAL) (DEPUTY)

RECEIVED BY

Umatilla County Surveyor


Date: 9-92

Rec'd by: KR

No. 92-106-C

**CERTIFIED RECORD OF LAND CORNER MONUMENTATION**  
 Corner common to Townships 5 & 6 North,  
 Ranges 37 & 38 East,  
 of the Willamette Meridian.

Detail of Monument established:

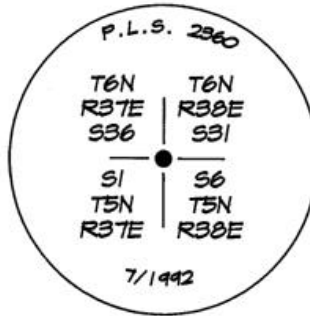

Description of monument and accessories I established to perpetuate the original location of this corner:

I marked the following bearing trees as accessories to this corner position:

An Engelman Spruce, 15 in. dia. bears  $N33^{\circ}21'25''E$ , a distance of 39.95 feet to center, with asphalt nail in  $3/4''$  brass washer mkd. "WA 25093 OR 2360" (typical for all new BT's) in center of "B" on face mkd. "T6NR38E531BT".

An Engelman Spruce, 17-1/2 in. dia. bears  $S75^{\circ}57'20''E$ , a distance of 11.98 feet to center, with asphalt nail in  $3/4''$  brass washer mkd. as noted in center of "B" on face mkd. "T5NR38E56BT".

A Grand Fir, 15 in. dia. bears  $S7^{\circ}54'12''W$ , a distance of 74.68 feet to center, with asphalt nail in  $3/4''$  brass washer mkd. as noted in center of "B" on face mkd. "T5NR37E51BT".

A Grand Fir, 37" dia. with large rotten scar on northerly side bears  $N68^{\circ}39'38''W$ , a distance of 23.04 feet to center, with asphalt nail mkd. as noted in center of "B" on face mkd. "T6NR37E536BT".

I affixed Umatilla County Surveyor Yellow Metal Bearing Object signs to the 4 new and the one remaining original Bearing Tree with bearings rounded to the nearest 15 minutes. I also affixed Bearing Tree signs (penalty for disturbance, etc.) to each tree.

Bearings are true, based upon Solar Observation by the "Hour angle method" taken at Latitude  $45^{\circ}56'52.4''$  North and Longitude  $118^{\circ}07'21.5''$  West.

**REGISTERED  
 PROFESSIONAL  
 LAND SURVEYOR**

*Paul W.P. Tomkins*

OREGON  
 JULY 26, 1988  
 PAUL W.P. TOMKINS  
 2360

8/26/92 RECEIVED BY

Office of \_\_\_\_\_ County of \_\_\_\_\_  
 State of \_\_\_\_\_, I hereby certify that the within instrument was  
 filed in this office for record on the \_\_\_\_\_ day of \_\_\_\_\_, 19\_\_\_\_.  
 \_\_\_\_\_ by \_\_\_\_\_  
 (COUNTY OFFICIAL) (DEPUTY)

Umatilla County Surveyor

Date 9-92

Rec'd By KR

No. 92-106-C