

USDA-FOREST SERVICE

Index File No. C-11


CORNER RECORD (SEARCH)
(Ref. FSM 7151.4)

Tract or Survey No. _____ Cor. No. _____

T 5N R. 38E R.D. W² County UMATILLA

Merid. WILL N.F. UMATILLA State OREGON

CORNER DIAGRAM

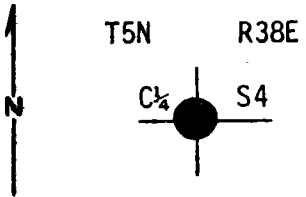


DESCRIBE CORNER MONUMENT FOUND

DESCRIBE BEARING TREES OR OTHER OFFICIAL ACCESSORIES FOUND

Description of monument and accessories | established to perpetuate the original location of this corner: At surveyed point set 1"x30" galvanized pipe with 3" brass cap stamped:

- Set pipe 24" in ground from which:
- A White Fir 21" dia bears N39⁰E 55.3 ft. scribed: C_{1/2} S4 BT.
- A White Fir 15" dia bears S34⁰E 43.6 ft scribed: C_{1/2} S4 BT.

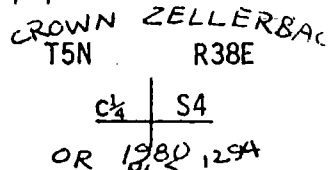

Attached 54-3 & 54-4 signs to both BT's. Attached brass washers stamped LS 1294 to foot blaze of both BT's. Painted blazes and 6" band around both BT's red.

Estab. By _____ Agency _____

Signature PLS 1294 Title _____ Division _____ Headquarters _____ Date 9/80

CORNER RECORD (PERPETUATION)

MONUMENT: DESCRIBE NEW MONUMENT SET, OR WORK DONE TO PRESERVE EXISTING MONUMENT

ACCESSORIES : DESCRIBE NEW BT'S WITNESS OBJECTS ETC. ESTABLISHED, OR WORK DONE TO PRESERVE EXISTING EVIDENCE

Work Done By _____ Title _____ Date _____ State Registration No. _____
or Agency _____
Certified Cor. Record Prepared ? Yes No Filed At: _____ Date _____

REMARKS

Index File No.

T.

R.

M.

Tract or Surv. No.

Cor.

C-11

5N1

38E