

USDA-FOREST SERVICE

Index File No. E-6

CORNER RECORD (SEARCH)


(Ref. FSM 7151.4)

Tract or Survey No. _____ Cor. No. _____

T 5N R. 3BE R.D. W² County UNIATILLA

Merid. WILL N.F. UNIATILLA State OREGON

CORNER DIAGRAM

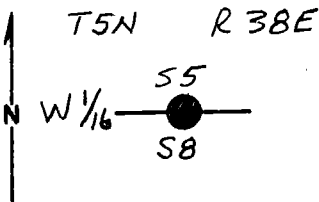

DESCRIBE CORNER MONUMENT FOUND

DESCRIBE BEARING TREES OR OTHER OFFICIAL ACCESSORIES FOUND

PHOTO IDENTIFICATION DATA

Photo No. _____
Filed At. _____
Object Ident. _____
Ident. By _____
Signature

PLANE COORDINATE POSITION DATA

State _____ Zone _____
X _____
Y _____
Estab. By _____
Agency

DESCRIBE CORNER LOCATION RELATIVE TO NEAR-BY FEATURES, ALSO HOW TO REACH CORNER

Signature HOWARD L. FERRY

Title _____ Division PLS 1294

Headquarters _____ Date 10/80

7100-52 (3-68)

CORNER RECORD (PERPETUATION)

Description of monument and accessories I established to perpetuate the original location of this corner:

At surveyed point set 1" x 30" galvanized pipe with 3" brass cap stamped :

CROWN ZELLERBACH
T5N R38E

- Set pipe 25" in ground. No stones available for mound.

S5

New BT's:

W 1/16 —

A White Fir 14" in diameter bears S41⁰E, 27.7 ft.
scribed W 1/16 S8 BT

S8

A White Fir 6" in diameter bears N62⁰E, 6.0 ft.
scribed W 1/16 S5 BT.

1980

PLS 1294

Attached 54-3 and 54-9 signs to both BT's.

- Attached brass washer stamped LS 1294 to foot blaze of both BT's Painted blazes and 6" band around both BT's Red.

10

REMARKS

Date

11

Index File No.

T.

R.

Q.

Tract or Surv. No.

Cor.

12

13

E-6

SN

38E