

USDA-FOREST SERVICE

Index File No. H-10

CORNER RECORD (SEARCH)

(Ref. FSM 7151.4)

Tract or Survey No. _____ Cor. No. _____


T 5N R. 38E

R.D. W² County UMATILLA

Merid. WILL

N.F. UMATILLA State OREGON

CORNER DIAGRAM

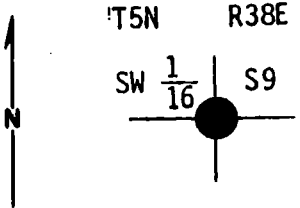

DESCRIBE CORNER MONUMENT FOUND

DESCRIBE BEARING TREES OR OTHER OFFICIAL ACCESSORIES FOUND

PHOTO IDENTIFICATION DATA

Photo No. _____

Filed At. _____

Object Ident. _____

Ident. By _____

Signature

PLANE COORDINATE POSITION DATA

State _____ Zone _____

X _____

Y _____

Estab. By _____

Agency

DESCRIBE CORNER LOCATION RELATIVE TO NEAR-BY FEATURES, ALSO HOW TO REACH CORNER

Signature

Title

Division

Headquarters

Date

7100-52 (3, 68)

S/ HOWARD L. PERRY

PLS 1294

10/80

CORNER RECORD (PERPETUATION)

Description of monument and accessories established to perpetuate the original location of this corner:

At surveyed point set 1"x30" galvanized pipe with 3" brass cap stamped:

Set pipe 24" in ground with mound of stones to cap.

From which:


A white Fir 6" dia. bears S57°E 9.8 ft. scribed: SW 1/16 S9 BT.

A white Fir 8" dia. bears N40°E 23.6 ft. scribed SW 1/16 S9 BT.

Attached 54-3 & 54-4 signs to both BT's. Attached brass washers stamped LS 1294 to foot blaze of both BT's. Painted blazes and 6" band around both BT's, red.

CROWN ZELLERBACH

T5N R38E

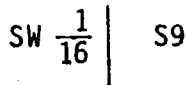

OR 1980 PLS 129A

Work Done By _____ Title _____ Date _____ State Registration No. _____
 or Agency _____

Certified Cor. Record Prepared? Yes No Filed At: _____ Date _____

REMARKS

Index File No.	T.	R.	M.	Tract or Surv. No.	Cor.
H-10	54	38E			