

USDA-FOREST SERVICE

Index
File No. H-6

CORNER RECORD (SEARCH)

(Ref. FSM 7151.4)


Tract or Survey No. _____ Cor. No. _____

T 5N R. 38E R.D. W² County UMATILLA

Merid. WILL N.F. UMATILLA State OREGON

CORNER DIAGRAM

DESCRIBE CORNER MONUMENT FOUND

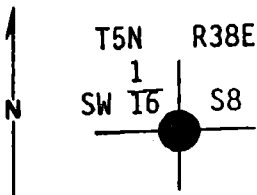

DESCRIBE BEARING TREES OR OTHER OFFICIAL ACCESSORIES FOUND

PHOTO IDENTIFICATION DATA

Photo No. _____
Filed At. _____
Object Ident. _____
Ident. By _____

DESCRIBE CORNER LOCATION RELATIVE TO NEAR-BY FEATURES, ALSO HOW TO REACH CORNER

PLANE COORDINATE POSITION DATA

State _____ Zone _____
X _____
Y _____
Estab. By _____

Signature

Title

Division

Headquarters

Date

7100-52 (3. 68)

5/ HOWARD L. PERRY

PLS 1294

11/80

CORNER RECORD (PERPETUATION)

Description of monument and accessories | established to perpetuate the original location of this corner:

At surveyed point set 1"x30" Galvanized Pipe with 3" brass cap stamped:


Set pipe 24" in ground with mound of dirt to cap.

From which:

A Spruce 10" dia. bears N36°E 80.4 ft., scribed: SW 1/16 S8 BT.

A Lodge Pole Pine 10" dia. bears S3°E 144.9 ft., scribed: SW 1/16 S8 BT.

Attached 54-3 and 54-4 signs to both BTs. Attached brass washers stamped LS 1294 to foot blaze of both BTs. Painted blazes and 6" band around both BTs. red.

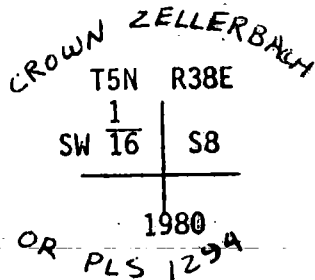

Certified Cor. Record Prepared? Yes No Filed At: _____

Date _____

REMARKS

Index File No.

T.

R.

M.

Te or Surv. No.

Cor.

H-6

5N

38E

18

17