

USDA-FOREST SERVICE

Index File No. J-9


CORNER RECORD (SEARCH)
(Ref. FSM 7151.4)

Tract or Survey No. _____ Cor. No. _____

T 5N R. 38E R.D. W2 County UMATILLA

Merid. WILL N.F. UMATILLA State OREGON

CORNER DIAGRAM

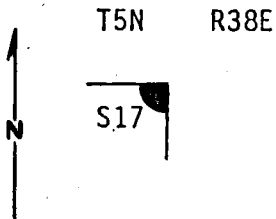

Description of corner evidence found:

Original stone, firmly set with 4 distinct notches on East edge, from which:

The original bearing tree, now a 26" Douglas Fir, alive and in good condition, previously opened partially by chainsaw and axe, but not to scribed face, bears S16½°W 84.5 ft.

PHOTO IDENTIFICATION DATA

Photo No. _____

Filed At. _____

Object Ident. _____

Ident. By _____

Signature

PLANE COORDINATE POSITION DATA

State _____ Zone _____

X _____

Y _____

Estab. By _____

Agency

DESCRIBE CORNER LOCATION RELATIVE TO NEAR-BY FEATURES, ALSO HOW TO REACH CORNER

Signature

Title

Division

Headquarters

Date

7100-52 (3 68)

(S) HOWARD L. PERRY

PLS 1294

10/80

CORNER RECORD (PERPETUATION)

Description of monument and accessories established to perpetuate the original location of this corner:

At corner location set a 1"x30" Galvanized Pipe with 3" brass cap stamped:

Set pipe 20" in ground with original stone buried alongside. Built mound of stone to cap.

From which:

The original Bearing Tree:

A 26" dia. Douglas Fir bears S16½°W 84.5 ft.

A Bearing Object:

A large boulder protruding forth from the mountain (10'x15') marked "BO" about 3½ ft. above the ground. BO is marked on farthest N.E. face of the rock. Rock is mostly round in shaped "X" bears S44°W 14.1 ft.

CROWN ZELLERBACH

T5N R38E

S17

1980

OR PLS 1294

Index File No.

T.

R.

M.

Tract or Surv. No.

Cor.

J-9

5N

38E

5-96

NE CORNER SECTION 17

TSN R38E

CAMPBELL SURVEY OF 1899

Ed: ORIGINAL CORNER STONE, FIRMLY SET WITH 4 DISTINCT NOTCHES ON EAST EDGE,

FROM WHICH THE ONLY ORIGINAL BEARING TREE, AN ORIG 6" FIR, NOW A 26" D. FIR, ALIVE AND IN GOOD CONDITION, PREVIOUSLY OPENED PARTIALLY BY CHAINSAW AND AXE BUT NOT TO SCRIBED FACE, BEARS S 16 1/2° W BA 2 FT. (REC. S 4 1/2° W 1 CHAIN 28 LKS.)

5-22-80

Ray J. Janglet ORLS 1099
GREG ORTON

COMPASS DECL: 19 1/2° EAST

CORNER IS LOCATED ON STEEP, BRUSHY EAST SLOPE UNDER ROCK BLIFFS, APPROX 3.75 CHS. EAST OF SE COR. SEC. 8.

WAS
IND
PIL

T

MORIS
CORNER



PROX

PROP

PLI

OBJ

LEVER

PLAN

STG

X

Y

BASE

NO. 10. SCRIBED FACE, BEARS S $16\frac{1}{2}^{\circ}$ W
84 $\frac{1}{2}$ FT. (REC. S $4\frac{1}{2}^{\circ}$ W | CHAIN 28 LBS.)

5-22-80

Lang J. Langlet ORLS 1099

COMPASS DECL. $19\frac{1}{2}^{\circ}$ EAST

CORNER IS LOCATED ON STEEP BRUSHY EAST
SLOPE UNDER ROCK BLUFFS, APPROX 3.75 CHS.
EAST OF SE COR. SEC. 8.






USDA-FOREST SERVICE

BLM

C.P.

Index File No. J-9 b or c

CORNER RECORD (SEARCH)

(Ref. FSM 7151.4)

Tract or Survey No. _____

Cor. No. J-9 b


T 5 N R. 38 E

R.D. _____ County _____

Merid. Villavieja Tr

N.F. _____ State Orryoy

CORNER DIAGRAM

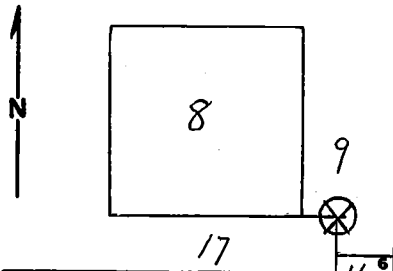

DESCRIBE CORNER MONUMENT FOUND

stone 24x12x6 mounted with 4 notches on East,

DESCRIBE BEARING TREES OR OTHER OFFICIAL ACCESSORIES FOUND

Fir (now about 20 in) bears S 4 1/2° W 1 ch 281RS.

PHOTO IDENTIFICATION DATA

Photo No. _____
 Filed At. _____
 Object Ident. _____
 Ident. By _____
 Signature _____

DESCRIBE CORNER LOCATION RELATIVE TO NEAR-BY FEATURES, ALSO HOW TO REACH CORNER.

Notches on stone were not visible

PLANE COORDINATE POSITION DATA

State _____ Zone _____
 X _____
 Y _____
 Estab. By _____
 Agency _____

Signature John Christy

Title FAA

Division _____

Headquarters _____

Date June 73

7100-52-(3/68)

CORNER RECORD (PERPETUATION)

MONUMENT : DESCRIBE NEW MONUMENT SET, OR WORK DONE TO PRESERVE EXISTING MONUMENT

ACCESSORIES : DESCRIBE NEW BT'S WITNESS OBJECTS ETC. ESTABLISHED, OR WORK DONE TO PRESERVE EXISTING EVIDENCE

Work Done By _____ **Title** _____ **Date** _____ **State Registration No.**
or Agency _____ 10

Certified Cor. Record Prepared ? Yes No **Filed At:** _____ **Date** _____ 11

REMARKS

Index File No. T. R. M. **Tract or Surv. No.** **Cor.** 12
U.S. G.P.O. 1977-725-576/586 13