

USDA-FOREST SERVICE

Index File No. N-5

CORNER RECORD (SEARCH)

(Ref. FSM 7151.4)

Tract or Survey No. \_\_\_\_\_ Cor. No. \_\_\_\_\_


T 5N R. 38E

R.D. WALLA WALLA County UMATILLA

Merid. WILLAMETTE

N.F. UMATILLA State OREGON

CORNER DIAGRAM

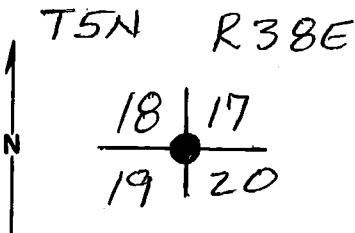

DESCRIBE CORNER MONUMENT FOUND

NONE

DESCRIBE BEARING TREES OR OTHER OFFICIAL ACCESSORIES FOUND

20" FIR N61°43' W, 145.2 ft, w/PARTLY HEALED BLAZE, FIR STUMP, 32", N80°24'E, 136.7 ft.

PHOTO IDENTIFICATION DATA

Photo No. \_\_\_\_\_  
Filed At. \_\_\_\_\_  
Object Ident. \_\_\_\_\_  
Ident. By \_\_\_\_\_  
Signature \_\_\_\_\_

DESCRIBE CORNER LOCATION RELATIVE TO NEAR-BY FEATURES, ALSO HOW TO REACH CORNER

PLANE COORDINATE POSITION DATA

State \_\_\_\_\_ Zone \_\_\_\_\_  
X \_\_\_\_\_  
Y \_\_\_\_\_  
Estab. By \_\_\_\_\_  
Agency \_\_\_\_\_

Signature P. TOMKINS

Title \_\_\_\_\_ Division PLS 2360 Headquarters \_\_\_\_\_

Date 8/94

CORNER RECORD (PERPETUATION)

MONUMENT: DESCRIBE NEW MONUMENT SET, OR WORK DONE TO PRESERVE EXISTING MONUMENT

ALUM. CAP ON RE-BAR IN M.O.S.

9

ACCESSORIES : DESCRIBE NEW BT'S WITNESS OBJECTS ETC. ESTABLISHED, OR WORK DONE TO PRESERVE EXISTING EVIDENCE

26" FIR S78°27'E, 109.0 FT,  
20" FIR S20°06'E, 133.9 FT

10

Work Done By. P. TOMKINS Title \_\_\_\_\_ Date \_\_\_\_\_ State Registration No. 2360  
or Agency \_\_\_\_\_

Certified Cor. Record Prepared? Yes  No  Filed At: \_\_\_\_\_ Date 8/94

11

REMARKS

12

Index File No. T. R. M. Tract or Surv. No. Cor.

N-5 5N 38E

13