

USDA-FOREST SERVICE

Index File No. R-7
T 5N R. 38E

CORNER RECORD (SEARCH)


(Ref. FSM 7151.4)

Tract or Survey No. _____ Cor. No. _____

Merid. WILLAMETTE

R.D. WALLA WALLA County UMATILLA
N.F. UMATILLA State OREGON

CORNER DIAGRAM

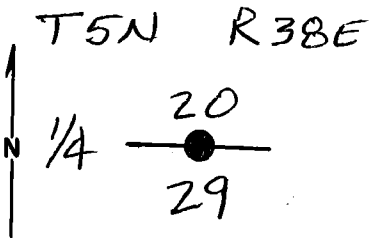

DESCRIBE CORNER MONUMENT FOUND

CHARRED STAKE IN M.O.S.

DESCRIBE BEARING TREES OR OTHER OFFICIAL ACCESSORIES FOUND

42" FIR 556°37' ~~W~~ E, 60 FT WITH PARTLY HEALED BLAZE & SCRIBES VISIBLE.

PHOTO IDENTIFICATION DATA

Photo No. _____
Filed At. _____
Object Ident. _____
Ident. By _____
Signature

DESCRIBE CORNER LOCATION RELATIVE TO NEAR-BY FEATURES, ALSO HOW TO REACH CORNER

PLANE COORDINATE POSITION DATA

State _____ Zone _____
X _____
Y _____
Estab. By _____
Agency

Signature
P. TOMKINS

Title

Division
PLS 2360

Headquarters

Date
8/94

FS-7100-52 (3/68)

CORNER RECORD (PERPETUATION)

MONUMENT: DESCRIBE NEW MONUMENT SET, OR WORK DONE TO PRESERVE EXISTING MONUMENT

ALUM. CAP ON RE-BAR IN M.O.S.

9

ACCESSORIES: DESCRIBE NEW BT'S WITNESS OBJECTS ETC. ESTABLISHED, OR WORK DONE TO PRESERVE EXISTING EVIDENCE

24" FIR N77°W, 51.3 FT

10

Work Done By P. TOMKINS Title _____ Date _____ State Registration No. 2360
or Agency _____

Certified Cor. Record Prepared? Yes No _____ Filed At: _____ Date _____

11

REMARKS

12

Index File No. T. R. M. Tract or Surv. No. Cor.

R-7

5N

38E

13