


Index
File No.

CORNER RECORD (SEARCH)
(Ref. FSM 6151.4)

Tract or Survey No. **Wenaha-Tucannon Wilderness** Cor. No. **AP 85-41**

T. 5 N. R. 39 E.
Merid. Willamette

R.D. Pomeroy & Walla Walla County **Wallowa**
N.F. Umatilla State **Oregon**

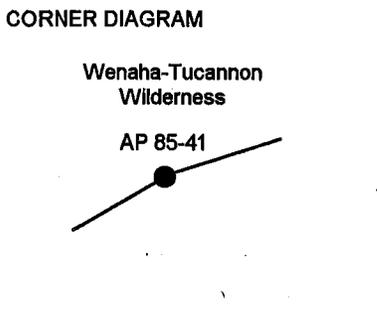

DESCRIBE CORNER MONUMENT FOUND
NONE

DESCRIBE BEARING TREES OR OTHER OFFICIAL ACCESSORIES FOUND
NONE

PHOTO IDENTIFICATION DATA
Photo No.
Filed At.
Object Ident.
Ident. By

Signature

DESCRIBE CORNER LOCATION RELATIVE TO NEAR-BY FEATURES, ALSO HOW TO REACH CORNER
From westerly junction of 6415 and 6415-020 travel easterly on 6415-020 approx. 1.10 miles and then walk N45 W, approx. 120 feet to the Angle Point which is a 13" Subalpine Fir which has Wilderness Boundary and Land Survey Moument signs attached.

PLANE COORDINATE POSITION DATA
State: Oregon Zone: North
X: 2700296.057 meters
Y: 247973.996 meters
Datum: NAD83(1991)

Signature	Title	Division	Headquarters	Date	
David Schlaich	Land Surveyor		S.O.	10/1998	FS-7100-52 (3/97)

CORNER RECORD (PERPETUATION)

MONUMENT: DESCRIBE NEW MONUMENT SET, OR WORK DONE TO PRESERVE EXISTING MONUMENT

Marked a 13" Subalpine Fir as a corner tree, with blaze scribed "WT/WILD" on a S 74 W face and a blaze scribed "AP 85-41" on a N 50 E face.

Both blazes have a 3/4" brass washer stamped "RLS 2308" nailed near the scribing.

ACCESSORIES: DESCRIBE NEW BT'S WITNESS OBJECTS ETC. ESTABLISHED, OR WORK DONE TO PRESERVE EXISTING EVIDENCE

Work Done By David Schlaich Title Land Surveyor Date 10/1998 State Registration No. or Agency _____
Certified Corner Record Prepared? Yes No Filed At: _____ Date _____

REMARKS

Index File No.

T. 5 N.

R. 39 E.

M. Willamette

Tract or Survey No.

Wenaha-Tucannon
Wilderness

Cor. AP 85-41