

(PA, Presently Pasted O)


Index
File No. C-21

CORNER RECORD (SEARCH)
(Ref. FSM 7151.4)

Tract or Survey No. _____
Cor. No. C-21

T 5S R. 30E R.D. Ukiah County Umatilla
Merid. Willamette N.F. Umatilla State Oregon

CORNER DIAGRAM

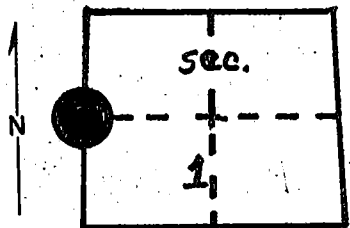

DESCRIBE CORNER MONUMENT FOUND

Material: Basalt stone, size: 20"x15"x9", Height above ground: 15" in ground., condition: good.

Monumented by BLM in 1978

DESCRIBE BEARING TREES OR OTHER OFFICIAL ACCESSORIES FOUND

PP 30" dia. bears N45 degrees E. 43 links
PP 24" dia. bears S35 degrees W. 52 links
A Pine 24" dia Brs. S-35 degrees E. 74 links marked 1/4 S BT
A Pine 12" dia Brs N 20 degrees W. 90 links marked 1/4 S BT

PHOTO IDENTIFICATION DATA

Photo No. _____
Filed At. _____
Object Ident. _____
Ident. By. _____
Signature

PLANE COORDINATE POSITION DATA

State _____ Zone _____
X _____
Y _____
Estab. By _____
Agency

DESCRIBE CORNER LOCATION RELATIVE TO NEAR-BY FEATURES, ALSO HOW TO REACH CORNER

Signature _____

Title _____

Division

USFS

Headquarters

Ukiah

Date

3/29/65

7100-52-(3/68)