


Index
 File No. G-9
 T 5 S R. 30 E
 Merid. Willamette

CORNER RECORD (SEARCH)
 (Ref. FSM 7151.4)

Tract or
 Survey No. _____
 Cor.
 No. _____

R.D. Ukiah County Umatilla
 N.F. Umatilla State Oregon

CORNER DIAGRAM

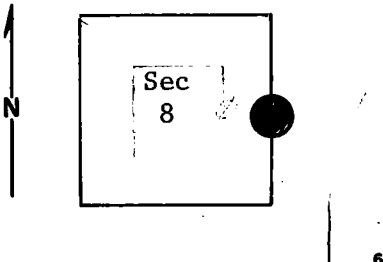

DESCRIBE CORNER MONUMENT FOUND

Brass Cap; see Monumentation File.

DESCRIBE BEARING TREES OR OTHER OFFICIAL ACCESSORIES FOUND

30" ponderosa pine with blaze on SW face, scribed 1/4 S.
 30" ponderosa pine with blaze on SE face, scribing barely visible.
 B.T. Poster 54-3 on both B.T.'s. Faded F.S. location poster on west B.T., dated 1954. HH, KE.

PHOTO IDENTIFICATION DATA

Photo No. _____
 Filed At. _____
 Object Ident. _____
 Ident. By _____
Signature

DESCRIBE CORNER LOCATION RELATIVE TO NEAR-BY FEATURES, ALSO HOW TO REACH CORNER

Basalt stone at intersection of bearings from B.T.'s but no marks visible on it.

PLANE COORDINATE POSITION DATA

State _____ Zone _____
 X _____
 Y _____
 Estab. By _____
Agency

Paced 600' north to old logging road and put up location poster 54-5.

Signature <u>B. Moore</u>	Title <u>Eng. Tech.</u>	Division <u>Umatilla</u>	Headquarters <u>S.O.</u>	Date <u>8/73</u>	7100-52-(3/68)
------------------------------	----------------------------	-----------------------------	-----------------------------	---------------------	----------------

CORNER RECORD (PERPETUATION)

MONUMENT: DESCRIBE NEW MONUMENT SET, OR WORK DONE TO PRESERVE EXISTING MONUMENT

ACCESSORIES : DESCRIBE NEW BT'S WITNESS OBJECTS ETC. ESTABLISHED, OR WORK DONE TO PRESERVE EXISTING EVIDENCE

Painted red ring around B.T.'s.

Work Done By _____ Title _____ Date _____ State Registration No. or Agency _____

Certified Cor. Record Prepared ? Yes No Filed At: _____ Date _____

REMARKS

Index File No. G-9 T. R. M. Tract or Surv. No. Cor. _____