

Index  
File No. L-25

## CORNER RECORD (SEARCH)

(Ref. FSM 7151.4)

Tract or  
Survey No. \_\_\_\_\_Cor.  
No. \_\_\_\_\_T 5 S. R. 30 E.R.D. Ukiah


County

UmatillaMerid. WillametteN.F. Umatilla

State

Oregon

## CORNER DIAGRAM

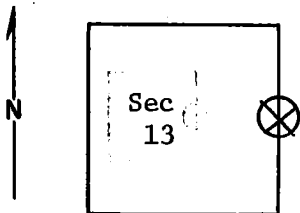

## DESCRIBE CORNER MONUMENT FOUND

Stone mound; mound 4' diam., 1' deep; 1' above ground; fair condition.

Mound is exactly ~~in~~ north-south fence line. Could not identify  $\frac{1}{4}$  corner stone.

2

## DESCRIBE BEARING TREES OR OTHER OFFICIAL ACCESSORIES FOUND

A location poster dated 1946 on a 10" ponderosa pine bears SW approx. 12'. Tree has old blazes. May be B.T. but probably too young for original.

A 10" Ponderosa pine bears N. 64°W., approx. 25'. It has a brand on it 14" high and 7' wide which appears to be R

3

## DESCRIBE CORNER LOCATION RELATIVE TO NEAR-BY FEATURES, ALSO HOW TO REACH CORNER

Corner sets in north-south fence line. There is a primitive road about 600' N.W. (Sugarbowl 7.5 minute quadrangle map shows old road as Jeep Trail.)

4

## 6 PHOTO IDENTIFICATION DATA

Photo No. \_\_\_\_\_

Filed At. \_\_\_\_\_

Object Ident. \_\_\_\_\_

Ident. By \_\_\_\_\_

Signature

7

## PLANE COORDINATE POSITION DATA

State \_\_\_\_\_ Zone \_\_\_\_\_

X \_\_\_\_\_

Y \_\_\_\_\_

Estab. By \_\_\_\_\_

Agency

8

Signature

Title

Division

Headquarters

Date

7100-52-(3/68)

T, Hollamon

Eng, Tech,

Z S,O,

4/19/74

5

T

**CORNER RECORD (PERPETUATION)**

**MONUMENT : DESCRIBE NEW MONUMENT SET, OR WORK DONE TO PRESERVE EXISTING MONUMENT**

**ACCESSORIES : DESCRIBE NEW BT'S WITNESS OBJECTS ETC. ESTABLISHED, OR WORK DONE TO PRESERVE EXISTING EVIDENCE**

9

I placed a location poster on gate post in line fence about  
900 ft. north.

10

Work Done By \_\_\_\_\_ Title \_\_\_\_\_ Date \_\_\_\_\_ State Registration No.  
or Agency \_\_\_\_\_

Certified Cor. Record Prepared ? Yes No Filed At: \_\_\_\_\_ Date \_\_\_\_\_

11

**REMARKS**

Index File No. T. R. M. Tract or Surv. No. Cor.

12

13