


CERTIFIED RECORD OF LAND CORNER MONUMENTATION

History of original corner establishment: Corner established in 1880 by George S. Pershin, under contract No. 361

80.00 set pine post on Level for cor. to sec. 35 and sec. 34, from which
A tamarack 10 in. diam. brs. N. 38° W. 10 lks dist.
A fir 5 in. diam. brs. N. 31° E. 19 lks dist.

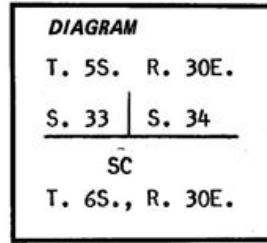

No record of subsequent remonumentation found in County Records.

Description of corner evidence found:


None.

Description of monument and accessories | established to perpetuate the original location of this corner:

Set 2½" x 30" iron pipe 28" in the ground with brass cap marked as shown: From which I scribed New Bearing Trees.

A 15" Fir N. 15° E. 46.3 ft. Mkd T. 5 S., R1 39 E., S 34 SC BT
A 10" Fir N. 38° 38' W. 21.5 ft. Mkd T. 5 S., R1 30 E., S 33 SC BT

I nailed a brass washer mkd. PLS 933 to the BT blaze of both trees. Set a steel fence post 1 ft. ~~West of corner.~~ Corner is 20. ft. South of E-W fence line. Used transit and steel tape, measuring to the center of BTs.

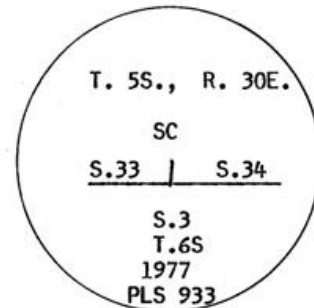

Office of County Surveyor County of Umatilla
State of Oregon, I hereby certify that the within instrument was filed in this office
for record on the day of , 19
David H. Klein by
(COUNTY OFFICIAL) (DEPUTY)

06-24-R

2-13