

USDA-FOREST SERVICE

Index

File No. Z-13

T5S

R30E

Merid. Willamette

CORNER RECORD (SEARCH)

Ref. FSM 7151.4

R.D. North Fork John Day

N.F. Umatilla

Tract or

Survey No

County Umatilla

State Oregon

Cor.

No.

x

Corner Diagram

T5S R30E

S33 | S34

S3

T6S R30E

1977

PLS 933

x

Photo Identification Data

Photo No.

filed at

Object Ident.

Ident. by

Signature

x

Plane Coordinate Position Data

State

Zone

X

Y

Estab. by

Agency

x

Signature

David L. Haddock

Title

Land Surveyor

Division

Headquarters

Pendleton, OR

Date

June 1988

7100.52

CORNER RECORD (PERPETUATION)

X _____ X
 Monument: Describe new monument set, or work done to preserve existing monument

None

X _____ X
 Accessories: Describe new BT's witness objects etc. established, or work done to preserve existing evidence

None

X _____ X						State Registration No.
Work done by	David L. Maddock	Title	Land Surveyor	Date		or Agency
Certified cor. record prepared? yes			no x	Filed at		852
X _____ X						Date

REMARKS

X _____ X
 Index File No. Z-13 T.58. R.30E. M. Willamette Tract or Survey No Cor.


USDA-FOREST SERVICE

Index
 File No. 2-13
 T 5S. R. 30E.
 Merid. Willamette

CORNER RECORD (SEARCH)
 (Ref. FSM 7151.4)
 R.D. Ukiah County
 N.F. Umatilla State

Tract or
 Survey No. _____
 Umatilla
 Oregon
 Cor.
 No. _____

CORNER DIAGRAM

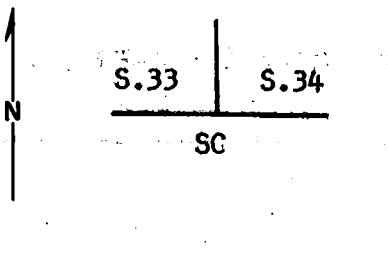

DESCRIBE CORNER MONUMENT FOUND

None
Set brass cap

DESCRIBE BEARING TREES OR OTHER OFFICIAL ACCESSORIES FOUND

None

PHOTO IDENTIFICATION DATA

Photo No. _____
 Filed At. _____
 Object Ident. _____
 Ident. By _____
Signature

DESCRIBE CORNER LOCATION RELATIVE TO NEAR-BY FEATURES, ALSO HOW TO REACH CORNER

From the intersection of U.S. Forest Roads 419N and 537N, go East about 2 miles to a fence, then East along fence 7.5 chns. to corner.

PLANE COORDINATE POSITION DATA

State _____ Zone _____
 X _____
 Y _____
 Estab. By _____
Agency

Signature
David H. Keller

Title Chief Division OPLS Headquarters 933

Date
7-77

7100-52-(3/68)

CORNER RECORD (PERPETUATION)

MONUMENT: DESCRIBE NEW MONUMENT SET, OR WORK DONE TO PRESERVE EXISTING MONUMENT

Set 2½" x 30" iron pipe with brass cap
 Pipe is 28" in ground

T. 5S., R. 30E.

SC

S.33 S.34

S.3

1977

PLS 933

9

Stamped:

ACCESSORIES: DESCRIBE NEW BT'S WITNESS OBJECTS ETC. ESTABLISHED, OR WORK DONE TO PRESERVE EXISTING EVIDENCE

A 15" fir bears N. 15° E. 46.3 ft.

A 10" fir bears N. 38° 38' W. 21.5 ft.

Set steel post 1 ft. West of corner w/sign.

Painted red band around bearing tree w/sign.

10

Work Done By T. Hamby Title Party Chief Date 6/23/77 State Registration No. _____
 or Agency _____

Certified Cor. Record Prepared? Yes No _____ Filed At: _____ Date _____

11

REMARKS

12

Index File No. T. R. M. Tract or Surv. No. Cor. 13