

USDA-FOREST SERVICE


Index  
File No. 2-23

CORNER RECORD (SEARCH)  
(Ref. FSM 7151.4)

Tract or  
Survey No. \_\_\_\_\_ Cor.  
No. \_\_\_\_\_

T 5S. R. 30E. R.D. Ukiah County Umatilla  
Merid. Willamette N.F. Umatilla State Oregon

CORNER DIAGRAM

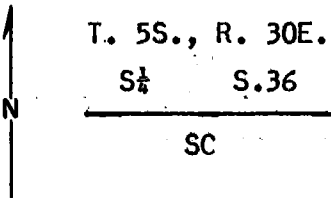

DESCRIBE CORNER MONUMENT FOUND

None  
*set brass cap*

DESCRIBE BEARING TREES OR OTHER OFFICIAL ACCESSORIES FOUND

None

PHOTO IDENTIFICATION DATA

Photo No. \_\_\_\_\_  
Filed At. \_\_\_\_\_  
Object Ident. \_\_\_\_\_  
Ident. By \_\_\_\_\_  
*Signature*

DESCRIBE CORNER LOCATION RELATIVE TO NEAR-BY FEATURES, ALSO HOW TO REACH CORNER

From the intersection of Oregon Highway and Five Mile Creek, go up Five Mile Creek Road about 3.8 miles, then West by Northwest about 0.6 miles, then walk Northeast about 9.0 chns. to the corner.

PLANE COORDINATE POSITION DATA

State \_\_\_\_\_ Zone \_\_\_\_\_  
X \_\_\_\_\_  
Y \_\_\_\_\_  
Estab. By \_\_\_\_\_  
*Agency*

*Signature*  
*David H. Kuber*

Title \_\_\_\_\_ Division OPLS Headquarters: 933 Date 7-77 7100-52-(3/68)

## CORNER RECORD (PERPETUATION)

MONUMENT: DESCRIBE NEW MONUMENT SET, OR WORK DONE TO PRESERVE EXISTING MONUMENT

T. 5S., R. 30E.

Set 2½" x 30" iron pipe with brass cap.

SC ¼ S.36

Pipe is 27" in ground.

1977

PLS 933

Stamped:

9

ACCESSORIES : DESCRIBE NEW BT'S WITNESS OBJECTS ETC. ESTABLISHED, OR WORK DONE TO PRESERVE EXISTING EVIDENCE

A 24" fir bears N. 69°12' W. 53.80 ft.

A 16" pine bears N. 31°58' E. 41.30 ft.

Set steel fence post 3 ft. East of corner w/sign.

Painted red band around bearing trees w/sign.

10

Work Done By T. Hamby Title Party Chief Date 6/23/77 State Registration No. or AgencyCertified Cor. Record Prepared ? Yes  No Filed At: Date

11

REMARKS

12

Index File No. T. R. M. Tract or Surv. No. Cor.

13