

Index
File No. C-1

CORNER RECORD (SEARCH)

(Ref. FSM 7151.4)

T 5 S. R. 31 E.


R.D. Ukiah County Umatilla

Tract or Survey No. _____
Cor. No. _____

Merid. Willamette

N.F. Umatilla State Oregon

CORNER DIAGRAM

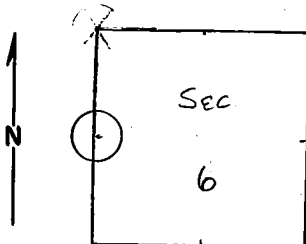

DESCRIBE CORNER MONUMENT FOUND

See remarks.

DESCRIBE BEARING TREES OR OTHER OFFICIAL ACCESSORIES FOUND

North-South fence only a Pilot Rock Lumber Co. (11-56) location poster on fence post (at rock jack). This poster indicates that $\frac{1}{4}$ corner is for East, $\frac{1}{4}$ for Sec. 1, T5S., R.30E. (True, but point was set as West $\frac{1}{4}$, Sec. 6, T.5S., R.31E. originally.)

PHOTO IDENTIFICATION DATA

Photo No. _____
Filed At. _____
Object Ident. _____
Ident. By _____
Signature

DESCRIBE CORNER LOCATION RELATIVE TO NEAR-BY FEATURES, ALSO HOW TO REACH CORNER

There is a primitive road roughly 600 feet west and a faint branch from it passes through the fence about 130 feet north of the approx corner location. (See Sugarbowl Creek 7.5 minute quad. map.)

PLANE COORDINATE POSITION DATA

State _____ Zone _____
X _____
Y _____
Estab. By _____
Agency

Signature

Title

Division

Headquarters

Date

7100-52-(3/68)

T. Hollamon

Engr. Tech.

4-21-76

CORNER RECORD (PERPETUATION)

MONUMENT: DESCRIBE NEW MONUMENT SET, OR WORK DONE TO PRESERVE EXISTING MONUMENT

9

ACCESSORIES : DESCRIBE NEW BT'S WITNESS OBJECTS ETC. ESTABLISHED, OR WORK DONE TO PRESERVE EXISTING EVIDENCE

10

Work Done By _____ Title _____ Date _____ State Registration No. or Agency _____

Certified Cor. Record Prepared ? Yes No Filed At: _____ Date _____ 11

REMARKS

GLO notes describe location as being on east slope. *It is more like south slope.* About half way between gully (south) and crest of hogback (north). There are two old, scattered rock mounds. One about 4 ft. west of fence, one about 24 feet west of fence. Each have a stone generally the size GLO notes describe. Neither has identifiable markings (GLO notes do not mention any markings). The information on the location poster would not place the 1/4 corner at exactly the location of either mound. I believe resurvey will be necessary to properly reestablish

12

Index File No. *1115* Corner. T. R. M. Tract or Surv. No. Cor. 13