

Index File No. G-9

CORNER RECORD (SEARCH)

Tract or Survey No. _____

Cor. No. L.L. 8
G-9


T 5S R. 31E

R.D. Ukiah County Umatilla

Merid. Willamette

N.F. Umatilla State Oregon

CORNER DIAGRAM

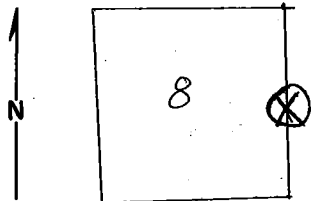

~~DESCRIBE CORNER MONUMENT FOUND~~ *Original notes*

set basalt stone 18"x12"x8" on level in mound of stone.
a pine 32" dia. brs. E 190 lks. No trees West

DESCRIBE BEARING TREES OR OTHER OFFICIAL ACCESSORIES FOUND 2

In company with R. Swainston and T. Buffington left S-518 from sec. line marker to cor. of fence that runs SW-NE. Found BT but no rocks.

Chained dist. was correct. Put tag on Pine snag.

PHOTO IDENTIFICATION DATA 6

Photo No. _____

Filed At. _____

Object Ident. _____

Ident. By _____

Signature 7

DESCRIBE CORNER LOCATION RELATIVE TO NEAR-BY FEATURES, ALSO HOW TO REACH CORNER 3

PLANE COORDINATE POSITION DATA

State _____ Zone _____

X _____

Y _____

Estab. By _____

Agency 8

Signature

Title

Division

Headquarters

Date

7100-52 4

W. V. H. AVERETT

Eng. Aide

3-22-65

REV. 65 5

CORNER RECORD (PERPETUATION)

MONUMENT: DESCRIBE NEW MONUMENT SET, OR WORK DONE TO PRESERVE EXISTING MONUMENT

9

ACCESSORIES DESCRIBE NEW BT'S WITNESS OBJECTS ETC. ESTABLISHED, OR WORK DONE TO PRESERVE EXISTING EVIDENCE

10

Work Done By _____ Title _____ Date _____ State Registration No. or Agency _____

Certified Cor. Record Prepared ? Yes No Filed At: _____ Date _____ 11

REMARKS

12

Index File No. G-9 T. R. M. Tract or Surv. No. Cor. 13