

Index File No. J-5

CORNER RECORD (SEARCH)

Tract or Survey No. _____

Cor. No. J-5 12


T 5S R. 31E

R.D. Ukiah County Umatilla

Merid. Willamette

N.F. Umatilla State Oregon

CORNER DIAGRAM

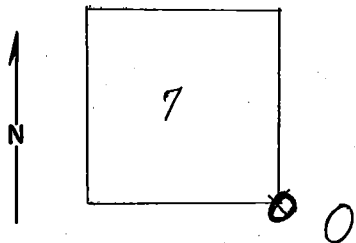

~~DESCRIBE CORNER MONUMENT FOUND~~ *Original notes*
set basalt stone 20x10x6 and a post in found of stone on E slope for cor. to sec. 7-8-17-18

DESCRIBE BEARING TREES OR OTHER OFFICIAL ACCESSORIES FOUND

PHOTO IDENTIFICATION DATA

Photo No. _____
Filed At. _____
Object Ident. _____
Ident. By _____
Signature

DESCRIBE CORNER LOCATION RELATIVE TO NEAR-BY FEATURES, ALSO HOW TO REACH CORNER
In company with R. Swainston and D. Vawter west on 90 along old fence for 2640'. Found old post in mound of stone. No evidence of sec. cor. Put an aluminum tag on post and painted post Day-Glo-Orange. Assumed it was cor.

PLANE COORDINATE POSITION DATA

State _____ Zone _____
X _____
Y _____
Estab. By _____
Agency

Signature

Title

Division

Headquarters

Date

7100-52

1st V. H. AVERETT

Eng. Aide

4-1-65

REV. 65 5

CORNER RECORD (PERPETUATION)

MONUMENT: DESCRIBE NEW MONUMENT SET, OR WORK DONE TO PRESERVE EXISTING MONUMENT

9

ACCESSORIES DESCRIBE NEW BT's WITNESS OBJECTS ETC. ESTABLISHED, OR WORK DONE TO PRESERVE EXISTING EVIDENCE

10

Work Done By _____ Title _____ Date _____ State Registration No. or Agency _____

Certified Cor. Record Prepared ? Yes No Filed At: _____ Date _____ **11**

REMARKS

12

Index File No. 1-5 J. R. M. Tract or Surv. No. Cor. **13**