

USDA-FOREST SERVICE

Index
File No. V-12

CORNER RECORD (SEARCH)

(Ref. FSM 7151.4)

Tract or Survey No. _____ Cor. No. _____


T 5S R. 32E

R.D. UKIAH County UMATILLA

Merid. WILLAMETTE

N.F. UMATILLA State OREGON

CORNER DIAGRAM

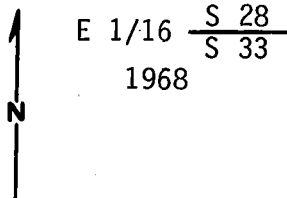

DESCRIBE CORNER MONUMENT FOUND

Found an iron pipe, firmly set, 2 1/2 ins. diam., in a mound of stone, 4 ft. base, to top, with brass cap mkd.

U.S. Dept. of The Interior
Bureau of Land Management

E 1/16 S 28 / S 33
1968

DESCRIBE BEARING TREES OR OTHER OFFICIAL ACCESSORIES FOUND

A Ponderosa Pine, 16 ins. diam., bears N. 64° E., 206 lks. dist.,
A Ponderosa Pine, 14 ins. diam., bears S. 28° E., 143 lks. dist.,
Both BT's alive and well-healed.

PHOTO IDENTIFICATION DATA

Photo No. _____
Filed At. _____
Object Ident. _____
Ident. By _____

Signature

PLANE COORDINATE POSITION DATA

State _____ Zone _____
X _____
Y _____
Estab. By _____

Agency

Signature

Title
LS 1099

Division

Headquarters

Date
9-17-84

7100-52-(3,68)

CORNER RECORD (PERPETUATION)

MONUMENT: DESCRIBE NEW MONUMENT SET, OR WORK DONE TO PRESERVE EXISTING MONUMENT

None

ACCESSORIES : DESCRIBE NEW BT'S WITNESS OBJECTS ETC. ESTABLISHED, OR WORK DONE TO PRESERVE EXISTING EVIDENCE

None

Work Done By Gary Langlitz Title LS 1099 Date 8-84 State Registration No. or Agency _____

Certified Cor. Record Prepared? Yes No Filed At: _____ Date _____

REMARKS

Index File No. V-12 T. 55 R. 32E M. WILLAMETTE Tract or Surv. No. _____ Cor. _____

Index

File No. V-12

T 5S R. 32E

Merid. Willamette

CORNER RECORD (SEARCH)

(Ref. FSM 7151.4)

R.D. Ukiah

County Umatilla

N.F. Umatilla

State Oregon


Tract or

Survey No. 5-95

Cor.

No. V-12

CORNER DIAGRAM

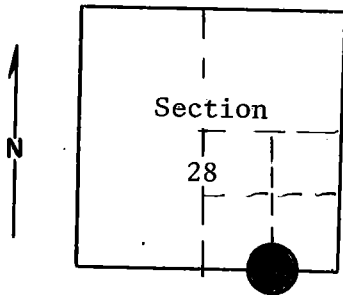

DESCRIBE CORNER MONUMENT FOUND

Material: Brass cap.

See BLM field notes in monumentation file.

DESCRIBE BEARING TREES OR OTHER OFFICIAL ACCESSORIES FOUND

PHOTO IDENTIFICATION DATA

Photo No. _____

Filed At. _____

Object Ident. _____

Ident. By _____

Signature

PLANE COORDINATE POSITION DATA

State _____ Zone _____

X _____

Y _____

Estab. By _____

Agency

Signature

Title

Division

Headquarters

Date

B. Moore

Engineering Technician

S. O.

December 15, 1974

7100-52-(3/68)

CORNER RECORD (PERPETUATION)

MONUMENT: DESCRIBE NEW MONUMENT SET, OR WORK DONE TO PRESERVE EXISTING MONUMENT

9

ACCESSORIES : DESCRIBE NEW BT's WITNESS OBJECTS ETC. ESTABLISHED, OR WORK DONE TO PRESERVE EXISTING EVIDENCE

10

Work Done By _____ Title _____ Date _____ State Registration No. _____
or Agency _____

Certified Cor. Record Prepared ? Yes No Filed At: _____ Date _____ 11

REMARKS

12

Index-File No. T. R. M. Tract or Surv. No. Cor. 13