

Index
File No. Y-19

CORNER RECORD (SEARCH)

(Ref. FSM 7151.4)

Tract or Survey No. _____
Cor. No. _____


T 55 R. 32E

R.D. UKIAH County UMATILLA

Merid. WILLAMETTE

N.F. UMATILLA State OREGON

CORNER DIAGRAM

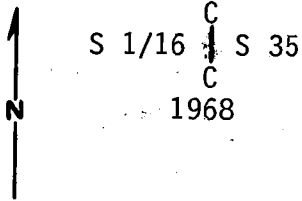

DESCRIBE CORNER MONUMENT FOUND

Found an iron pipe, firmly set,
2½ ins. diam., extending 4"
above ground, with brass cap
mkd.

U.S. Dept. of Interior
Bureau of Land Management
S 1/16 | S 35
C
C
1968

DESCRIBE BEARING TREES OR OTHER OFFICIAL ACCESSORIES FOUND

A Fir, 8 ins. diam., bears N. 88½° E., 30½ lks. dist.,
A Fir, 8 ins. diam., bears N. 55° W., 16 lks. dist.,
Both BT's are alive and well-healed.

PHOTO IDENTIFICATION DATA

Photo No. _____
Filed At. _____
Object Ident. _____
Ident. By _____
Signature _____

DESCRIBE CORNER LOCATION RELATIVE TO NEAR-BY FEATURES, ALSO HOW TO REACH CORNER

PLANE COORDINATE POSITION DATA

State _____ Zone _____
X _____
Y _____
Estab. By _____
Agency _____

Signature Ray J. Douglas

Title _____ Division _____ Headquarters _____ Date 9-17-84
LS 1099 7100-52-(3,68)

CORNER RECORD (PERPETUATION)

MONUMENT : DESCRIBE NEW MONUMENT SET, OR WORK DONE TO PRESERVE EXISTING MONUMENT

None

ACCESSORIES : DESCRIBE NEW BT'S WITNESS OBJECTS ETC. ESTABLISHED, OR WORK DONE TO PRESERVE EXISTING EVIDENCE

None

Work Done By Gary Langlitz Title LS 1099, Date 8-84 State Registration No. or Agency _____

Certified Cor. Record Prepared ? Yes (No) Filed At: _____ Date _____

REMARKS

Index File No. Y-19 T. 55 R. 32E M. WILLAMETTE Tract or Surv. No. _____ Cor. _____