

Index
File No. 2-5

CORNER RECORD (SEARCH)
(Ref. FSM 7151.4)

Tract or
Survey No. _____ Cor.
No. _____


T 5S R. 32E

R.D. UKIAH County UMATILLA

Merid. WILLAMETTE

N.F. UMATILLA State OREGON


CORNER DIAGRAM

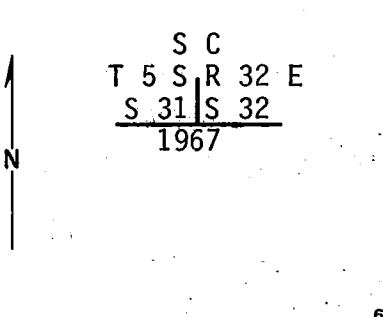

DESCRIBE CORNER MONUMENT FOUND

Found an iron pipe, firmly set,
2½ ins. diam., with brass cap
mkd.

U.S. Dept. of Interior
Bureau of Land Management

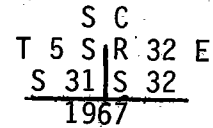

DESCRIBE BEARING TREES OR OTHER OFFICIAL ACCESSORIES FOUND

A root hole, bears N. 9°E., 11 lks. dist., with a down fir alongside,
12 ins. diam., with illegible scribe marks visible on open blaze.
(Record, N. 12°E.)

A root hole, bears N. 57°W., 52 lks. dist., with a down fir alongside,
25 ins. diam., with illegible scribe marks visible on open blaze.
(Record, N. 63°W.)

PHOTO IDENTIFICATION DATA

Photo No. 280-293
Filed At. UMATILLA NAT. FOR.
Object Ident. Direct
Ident. By S. Jangley
SIGNATURE

A Larch, 14 ins. diam., bears N. 11°E., 106 lks. dist., scribing
visible on unhealed blaze.

A Lodgepole Pine, 8 ins. diam., bears N. 24°W., 92 lks. dist.,
scribing visible on unhealed blaze.

PLANE COORDINATE POSITION DATA

State _____ Zone _____
X _____
Y _____
Estab. By _____
Agency

S. Jangley
SIGNATURE

Title LS 1099 Division _____ Headquarters _____ Date 9-16-84 FS-7100-52 (3/68)

CORNER RECORD (PERPETUATION)

MONUMENT: DESCRIBE NEW MONUMENT SET, OR WORK DONE TO PRESERVE EXISTING MONUMENT

None

ACCESSORIES : DESCRIBE NEW BT'S WITNESS OBJECTS ETC. ESTABLISHED, OR WORK DONE TO PRESERVE EXISTING EVIDENCE

None

Work Done By Gary Langlitz Title LS 1099 Date 8-84 State Registration No. or Agency _____
Certified Cor. Record Prepared? Yes No Filed At: _____ Date _____

REMARKS

Corner located along west edge of N-S Road, 15' N. of E-W fence.

Index File No. Z-5 T. 5S R. 32E M. WILLAMETTE Tract or Surv. No. _____ Cor. _____