

USDA-FOREST SERVICE

Index
File No. C-24

CORNER RECORD (SEARCH)

(Ref. FSM 7151.4)

Tract or
Survey No. _____ Cor.
No. _____


T 5S R. 33E

R.D. Ukiah County Umatilla

Merid. W.M.

N.F. Umatilla State Or.

CORNER DIAGRAM

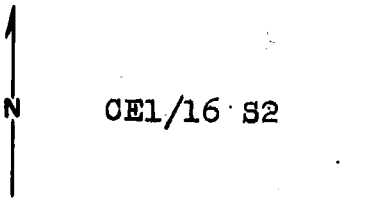

DESCRIBE CORNER MONUMENT FOUND

None.

DESCRIBE BEARING TREES OR OTHER OFFICIAL ACCESSORIES FOUND

None.

PHOTO IDENTIFICATION DATA

Photo No. _____
Filed At. _____
Object Ident. _____
Ident. By _____
Signature

DESCRIBE CORNER LOCATION RELATIVE TO NEAR-BY FEATURES, ALSO HOW TO REACH CORNER

Cor. falls in flat pasture just W. of fence. From $\frac{1}{4}$ cor. to E, go $\frac{1}{4}$ mi. W. along posted property line.

PLANE COORDINATE POSITION DATA

State _____ Zone _____
X _____
Y _____
Estab. By _____
Agency

Signature
F. L. Munro

Title L.S. Division _____ Headquarters _____ Date 9/13/84 7100-52-(3/68)

CORNER RECORD (PERPETUATION)

MONUMENT: DESCRIBE NEW MONUMENT SET, OR WORK DONE TO PRESERVE EXISTING MONUMENT

2 1/2" alum. pipe with 3" alum. cap mks

E1/16

0-0

S2

PLS 1832

1984

Build stone mound around monument.

ACCESSORIES: DESCRIBE NEW BT'S, WITNESS OBJECTS ETC. ESTABLISHED, OR WORK DONE TO PRESERVE EXISTING EVIDENCE

Lodgepole, 10", N83-3/4 E, 184.3 ft.

P. pine, 17", S41 E, 205.3 ft.

BTs have reqd. paint, tags & signs.

Work Done By F.S. Munro Title L.S.

Date 9/13/84 State Registration No. 1832
or Agency

Certified Cor. Record Prepared? Yes No

Filed At: Umatilla Co. Surveyor

Date

REMARKS

Index File No. C-24

T.

58

R.

33E

M.

W.M.

Tract or Surv. No.

Cor.