

USDA-FOREST SERVICE

Index
File No. E-19

CORNER RECORD (SEARCH)

(Ref. FSM 7151.4)

Tract or
Survey No. _____ Cor.
No. _____


T 58 R. 33E

R.D. Ukiah County Umatilla

Merid. W.M.

N.F. Umatilla State Or.

CORNER DIAGRAM

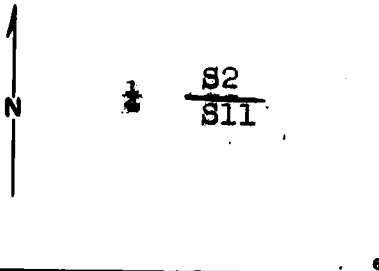

DESCRIBE CORNER MONUMENT FOUND

Stone 12"x10"x6" with no marks evident.

DESCRIBE BEARING TREES OR OTHER OFFICIAL ACCESSORIES FOUND

Fir snag, 16", N33°E, 16.3 ft.
P. pine, 23", dead & down, root hole bears S36°W,
17.2 ft.

PHOTO IDENTIFICATION DATA

Photo No. _____
Filed At. _____
Object Ident. _____
Ident. By _____
Signature

DESCRIBE CORNER LOCATION RELATIVE TO NEAR-BY FEATURES, ALSO HOW TO REACH CORNER

Cor. falls in timber on NW slope approx 500'
N of powerline and approx. 600' E of K tag on
5440 rd.

PLANE COORDINATE POSITION DATA

State _____ Zone _____
X _____
Y _____
Estob. By _____
Agency

Signature
J. J. Munro

Title L.S. Division _____ Headquarters _____ Date 9/26/84 7100-52 (3/68)

CORNER RECORD (PERPETUATION)

MONUMENT: DESCRIBE NEW MONUMENT SET, OR WORK DONE TO PRESERVE EXISTING MONUMENT

2 1/2" x 30" alum. pipe with 3" alum cap mkd:

T58 R33E
82
811
PLS 1832
1984

ACCESSORIES: DESCRIBE NEW BT'S WITNESS OBJECTS ETC. ESTABLISHED, OR WORK DONE TO PRESERVE EXISTING EVIDENCE

D. fir, 11", N11°W, 18.8 ft.
D. fir, 11", S42 1/4°W, 38.9 ft.

BTs have reqd. paint, tags & signs.

Work Done By F.S. Munro Title L.S. Date 9/16/84 State Registration No. 1832
or Agency
Certified Cor. Record Prepared? Yes No Filed At: Umatilla Co. Surveyor Date

REMARKS

Index File No. E-19 T. 58 R. 33E M. W.M. Tract or Surv. No. Cor. 13

Index
File No. E-19

CORNER RECORD (SEARCH)

Tract or

LL

Cor.

8

Survey No.

No. E-19

T 5S R. 33E

R.D. Ukiah


County Umatilla

Merid. Willamette

N.F. Umatilla

State Oregon

CORNER DIAGRAM

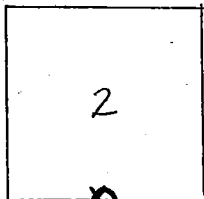

~~DESCRIBE CORNER MONUMENT FOUND~~ *Original notes*

set basalt stone 12"x10"x6", 8" in ground on NW slope for $\frac{1}{4}$ s.cor.
fir 12" dia. brs. N31E, 26 lks (16') dist marked $\frac{1}{4}$ s BT
pine 20" " " S28W, 28 lks (18') " " " "

DESCRIBE BEARING TREES OR OTHER OFFICIAL ACCESSORIES FOUND

a marker on S524 then east 620' to a pile of rocks

PHOTO IDENTIFICATION DATA

Photo No. _____

Filed At. _____

Object Ident. _____

Ident. By _____

Signature

PLANE COORDINATE POSITION DATA

State _____ Zone _____

X _____

Y _____

Estab. By _____

Agency

Signature

Title

Division

Headquarters

Date

7100-52

REV. 65 5

CORNER RECORD (PERPETUATION)

MONUMENT: DESCRIBE NEW MONUMENT SET, OR WORK DONE TO PRESERVE EXISTING MONUMENT

ACCESSORIES DESCRIBE NEW BT'S WITNESS OBJECTS ETC. ESTABLISHED, OR WORK DONE TO PRESERVE EXISTING EVIDENCE

Work Done By _____ Title _____ Date _____ State Registration No. or Agency _____
Certified Cor. Record Prepared ? Yes No Filed At: _____ Date _____

REMARKS

Index File No. *E-19* T. R. M. Tract or Surv. No. Cor. 12 13