


CERTIFIED RECORD OF LAND CORNER MONUMENTATION

E-7

History of original corner establishment:

1882, George S. Pershin, U.S. Deputy Surveyor, while subdividing the township under G.L.O. Contract No. 430 established the corner as follows:
Set a basalt stone, 12 x10 x 8 ins., 8 ins. in the ground on E. slope for 1/4 sec corner, marked 1/4 on N. face from which:
A fir 10 in. diam bears N. 40° E., 20 lks dist. marked 1/4 S. B.T.
A tamarack 14 in. diam. bears S. 57° E. 22 lks dist. marked 1/4 S. B.T.

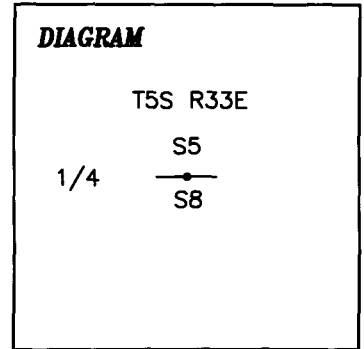


1977, Craig L. Wanless, BLM Cadastral Surveyor, found the 1/4 cor. of secs. 5 and 8, monumented with the original basalt stone, 12 x 10 x 8 ins., firmly set 6 ins. in the ground, mkd. 1/4 on N. face, from which the remains of the original bearing trees:

A fir snag, 29 ins. diam. bears N. 18° E., 20 lks. dist., with healed blaze. (Record N. 40° E.)
A root hole, bears S. 57° E., 22 lks. dist., with a down larch alongside, 15 ins diam., no marks visible.
At corner point
Set an iron post, 28 ins. long, 2 1/2 ins. diam., 24 ins. in the ground, with brass cap, from which new bearing trees
A grand fir, 8 ins. diam., bears N. 40° E., 2 1/2 lks. dist., mkd. 1/4 S5 BT.
A grand fir, 10 ins. diam., bears S. 63° W., 43 1/2 lks. dist., mkd 1/4 S8 BT.
Deposit corner stone and set 5 ft. steel fence post alongside iron post.

Description of corner evidence found:

Found a 2 1/2 ins. diam. iron pipe, with 3 1/4 in. brass cap as shown, projecting 3 ins out of the ground, located in a small mound of stones.

No evidence of BT's found.

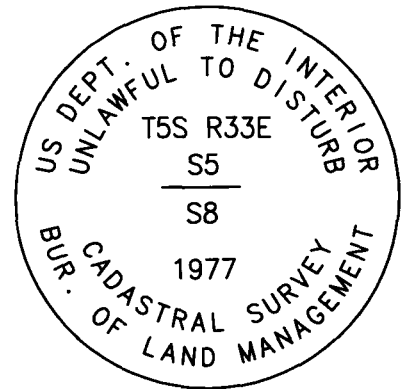

Description of monument and accessories I established to perpetuate the original location of this corner:

New References:

A 10 in. Pine bears N 54° W, 21.1 ft. to center, scribed 1/4 S5 BT.
A 8 in. Pine bears S 83° E, 17.2 ft to center, scribed 1/4 S8 BT.

The new bearing trees have a 2" aluminum washer stamped "2645" fastened to the base of blaze with magnetic "PK" nail.

Reference bearings were observed with a Ranger hand held compass

See Survey # 14-006-C

Date:
Declination: 17° East
Witness: Robert Flora

