

USDA-FOREST SERVICE


Index
File No. N-11
T 55 R. 33E
Merid. Willamette

CORNER RECORD (SEARCH)

(Ref. FSM 7151.4)

R.D. Ukiah County Umatilla
N.F. Umatilla State Oregon
Tract or Survey No. _____ Cor. No. 14

CORNER DIAGRAM

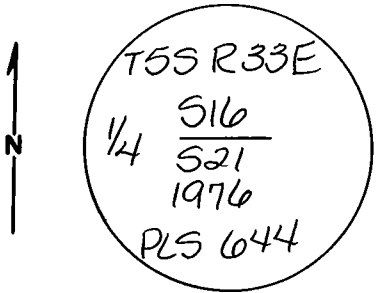

DESCRIBE CORNER MONUMENT FOUND

A 2 1/2" dia Brass Cap on 2 1/2" galvanized pipe
in a mound of stones

DESCRIBE BEARING TREES OR OTHER OFFICIAL ACCESSORIES FOUND

A 36" Ponderosa Pine bears S 45° E, 9.9 feet
A 24" Ponderosa Pine bears N 13° W, 67.9 feet from
which an original BT (now stump) bears SW 5 feet
BT's have signs # 54-3 & 54-4 and Brass Washers

PHOTO IDENTIFICATION DATA

Photo No. _____
Filed At. _____
Object Ident. _____
Ident. By _____
Signature

PLANE COORDINATE POSITION DATA

State _____ Zone _____
X _____
Y _____
Estab. By _____
Agency

DESCRIBE CORNER LOCATION RELATIVE TO NEAR-BY FEATURES, ALSO HOW TO REACH CORNER

A fence corner is 8 feet South and 8 feet East
Fence runs North and East

Signature
David H Kler

Title
PLS 933

Division

Headquarters

Date

7/16/84

7100-52 (3-68)

CORNER RECORD (PERPETUATION)

MONUMENT: DESCRIBE NEW MONUMENT SET, OR WORK DONE TO PRESERVE EXISTING MONUMENT

None

ACCESSORIES: DESCRIBE NEW BT'S WITNESS OBJECTS ETC. ESTABLISHED, OR WORK DONE TO PRESERVE EXISTING EVIDENCE

None

Work Done By R. Panches Title Party Chief Date 7/9/84 State Registration No. _____
or Agency _____

Certified Cor. Record Prepared? Yes No _____ Filed At: _____ Date _____

REMARKS

Index File No. N-11 T. 5S R. 33 E. W. M.

Tract or Surv. No. _____

Cor. 1/4

Index
File No. N-11

CORNER RECORD (SEARCH)
(Ref. FSM 7151.4)

Tract or
Survey No. _____

Cor. No. N-11

T SS R. 33E

R.D. UKIAH


County UMATILLA

Merid. _____

N.F. UMATILLA

State OREGON

CORNER DIAGRAM

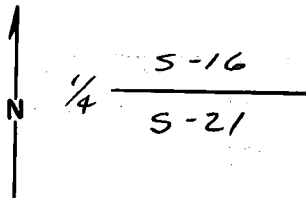

DESCRIBE CORNER MONUMENT FOUND

FND. STONE, CALL SIZE, 60' ± NW OR CORNER
STONE MARKED 1/4

DESCRIBE BEARING TREES OR OTHER OFFICIAL ACCESSORIES FOUND

12.8" P. PINE STUMP WITH SCRIBES
36" P. PINE WITH SCRIBES

PHOTO IDENTIFICATION DATA

Photo No. _____
Filed At. _____
Object Ident. _____
Ident. By _____

Signature

PLANE COORDINATE POSITION DATA

State _____ Zone _____
X _____
Y _____
Estab. By _____
Agency _____

Signature

[Handwritten Signature]

Title

[Handwritten Title: SUR]

Division

Headquarters

Date

[Handwritten Date: 10/76]

7100-52-(3/68)

CORNER RECORD (PERPETUATION)

MONUMENT: DESCRIBE NEW MONUMENT SET, OR WORK DONE TO PRESERVE EXISTING MONUMENT

SET 2 1/2" X 30" IRON PIPE WITH BRASS CAP.

ACCESSORIES: DESCRIBE NEW BT'S WITNESS OBJECTS ETC. ESTABLISHED, OR WORK DONE TO PRESERVE EXISTING EVIDENCE

ORIG. BTS

A 36" P. PINE, S45E, 10.0 FT

A 28" P PINE STUMP N22W, 66 FT

NEW BT

A 28" P. PINE N13W, 67.9, FT.

Work Done By DT GRIFFITH Title SURVEYOR Date 10/77 State Registration No. or Agency O.R.E.P.L.S. 644

Certified Cor. Record Prepared? Yes No Filed At: UMATILLA Co. Ct. House Date 1/77

REMARKS

Index File No. 1 T. 55 R. 33E W.M. Tract or Surv. No. Cor. N

N 11-11

11