


CERTIFIED RECORD OF LAND CORNER MONUMENTATION

N-9

History of original corner establishment:


1882, George S. Pershin, U.S. Deputy Surveyor, while subdividing the township under G.L.O. Contract No. 430 established the corner as follows:
Set a basalt stone, 18 x8 x 7 ins., 12 ins. in the ground on steep NE slope for corner to sec. 16, 17, 20, and 21. Marked 3 notches on S. and 4 notches on E. edges from which:
A fir 8 in. diam. bears N. 72° E., 44 lks dist. marked T5S R33E S. 16 B.T.
A tamarack 18 in. diam. bears S. 53° E., 53 lks dist. marked T5S R33E S. 21 B.T.
A fir 8 in. diam. bears S. 64° W., 26 lks dist. marked T5S R33E S. 20 B.T.
A fir 28 in. diam. bears N. 40° W., 9 lks dist. marked T5S R33E S. 17 B.T.

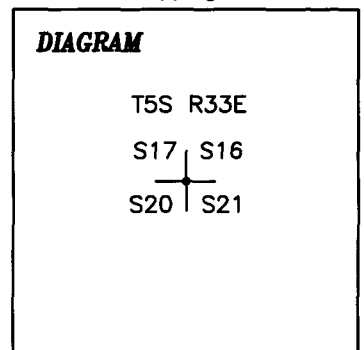

1977, Craig L. Wanless, BLM Cadastral Surveyor, reset the cor. of secs. 16, 17, 20, and 21, determined at record distance from the remains of the original bearing trees:
A grand fir 17 in. diam. bears N. 72° E., 44 lks dist. with fragmentary marks visible on open and burned blaze.
A decayed larch stump, size indeterminate. bears S. 53° E., 53 lks dist. with fragmentary marks visible on open and burned blaze.
A fir stump, size indeterminate. bears S. 64° W., 26 lks dist. with fragmentary marks visible on open and burned blaze.
A fir snag, 30 in. diam. bears N. 40° W., 9 lks dist. with fragmentary marks visible on open and burned blaze.
Set an iron post, 28 ins. long, 2 1/2 ins. diam., 24 ins. in the ground, with brass cap. From which:
A grand fir, 6" diam., bears S 43° E, 27 lks. dist., marked T5S R33e S21 BT
A grand fir, 4" diam., bears S 53° W, 87 lks. dist., marked T5S R33E S20 BT
A grand fir, 10" diam, bears N 72° W, 94 lks. dist., marked T5S R33E S17 BT
Set a 5ft steel fence post alongside iron post.

Description of corner evidence found:

Found a 2 1/2 ins. diam. iron pipe, with 3 1/4 in. brass cap as shown, From which:
A grand fir 17 in. diam. bears N. 72° E., 44 lks dist. with a healed blaze.
A grand fir, 6" diam., bears S 43° E, 27 lks. dist., with partially healed blaze. fragmentary scribing visible
A dead and down fir, 4" diam., bears S 53° W, 87 lks. dist., with open blaze scribed T5S R33E S20 BT
A grand fir, 10" diam, bears N 72° W, 94 lks. dist., with a healed blaze.
Bent 5ft steel fence post alongside iron post.

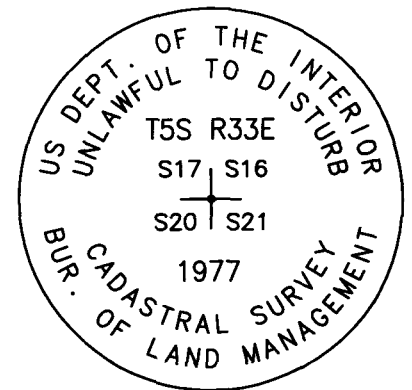

Description of monument and accessories I established to perpetuate the original location of this corner:

New References:
A 6 in. Pine bears S 68° W, 27.8 ft. to center, scribed X BT.

The new bearing tree has a 2" aluminum washer stamped "2645" fastened to the base of blaze with magnetic "PK" nail.

Reference bearings were observed with a Ranger hand held compass

See Survey # 14-006-C

Date:
Declination: 17° East
Witness: Robert Flora

