


CERTIFIED RECORD OF LAND CORNER MONUMENTATION

P-11

History of original corner establishment:

1985, Victor M. McLind, under contract with the Umatilla National Forest, established the corner as follows:
Center 1/4 Corner of Section 21, T5S R33E
At point of intersection of the E-W Centerline and the N-S Centerline,
Set a 2" x 30" aluminum pipe with 2 1/2" aluminum cap, 26" in the ground in a stone mound. Bearing trees as follows:
A 8" larch, scribed "C 1/4 S21 BT" bears S 30° W, 47.7 ft.
A 8" fir, scribed "C 1/4 S21 BT" bears N 83° W, 27.3 ft.

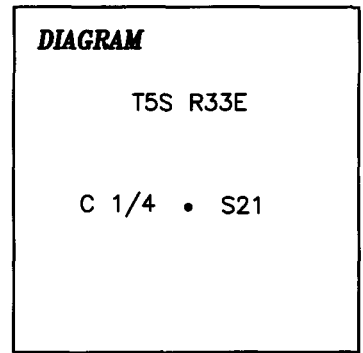


Note: From the above Center 1/4 set by me a found 2" galv. iron pipe with 2 1/2" brass cap mkd. "T5S R33E, C 1/4 S21, 1984, PLS 933" bears S 78° 39' 40" E, 23.73 feet.

Description of corner evidence found:

Found a 2 ins. diam pipe with aluminum cap as shown, in a small grass covered mound of stone.

A 10 in. larch bears S 30° W, 47.7 feet with a healed blaze.
A dead and down fir, bears N 83° W, 28 feet with partially healed blaze, some scribing visible.

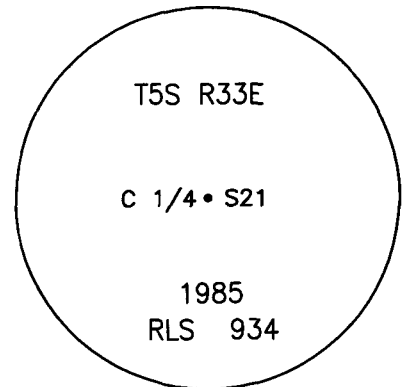

Description of monument and accessories I established to perpetuate the original location of this corner:

New Reference:
A 28 in. larch bears N 58° W, 55.8 ft. to center, scribed C1/4 S21 BT.

The new bearing tree has a 2" aluminum washer stamped "2645" fastened to the base of blaze with magnetic "PK" nail.

Reference bearings were observed with a Ranger hand held compass

See Survey # 14-006-C

Date:
Declination: 17° East
Witness: Robert Flora

REGISTERED
PROFESSIONAL
LAND SURVEYOR
Mark A. Lichtenthaler
OREGON
JANUARY 18, 1994
MARK A. LICHTENTHALER
2645
EXPIRES 12-31-2014