


**CERTIFIED RECORD OF LAND CORNER MONUMENTATION**

P-9

**History of original corner establishment:**


1882, George S. Pershin, U.S. Deputy Surveyor, while subdividing the township under G.L.O. Contract No. 430 established the corner as follows:  
Set a basalt stone, 16 x10 x 5 ins., 12 ins. in the ground on East slope for 1/4 sec corner, marked 1/4 on West face from which  
A pine 5 in. diam bears N. 66° E., 32 lks dist. marked 1/4 S. B.T.  
A pine 8 in. diam. bears S. 67° E. 71 lks dist. marked 1/4 S. B.T.

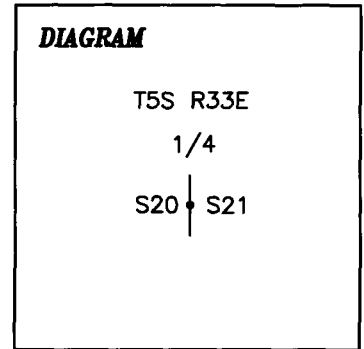

1976, Duane I. Griffith, PLS #644, found stone call size on ground near fence corner. Found SW BT, scribes visible. No evidence of other BT found.  
At record bearing and distance from SW BT  
Set 2 1/2" x 30" iron pipe with brass cap 21 ins. in the ground, from which:  
Original BT: A 18" P. Pine, bears S 60° W, 46.9 ft scribes visible.  
New BT: A 26" P. Pine, bears N 34° E, 81.4 ft, mkd. T5S R33E 1/4 S21 BT.  
Set steel fence post 2 # West.  
Raised mound of stone.  
Buried stone North and alongside pipe.

**Description of corner evidence found:**

Found a 2 1/2 ins. diam. iron pipe, with 2 1/2 ins. brass cap as shown, in a mound of stone.  
A Ponderosa pine, 26 in. diam. bears S. 60° W., 46.9 ft with a healed blaze.  
A stump hole with decayed remnants bears N. 34° E., 80 ft.

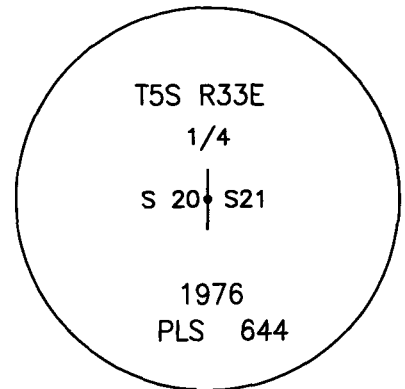

**Description of monument and accessories I established to perpetuate the original location of this corner:**

New Reference:  
A 12 in. Douglas Fir bears N 41° E, 21.7 ft. to center, scribed 1/4 S20 BT.

The new bearing tree has a 2" aluminum washer stamped "2645" fastened to the base of blaze with magnetic "PK" nail.

Reference bearings were observed with a Ranger hand held compass

See Survey # 14-006-C

Date:  
Declination: 17° East  
Witness: Robert Flora

REGISTERED PROFESSIONAL LAND SURVEYOR  
*Mark A. Lichtenthaler*  
OREGON  
JANUARY 18, 1994  
MARK A. LICHTENTHALER  
2645  
EXPIRES 12-31-2014