


History of original corner establishment:

Unsurveyed - subdivided section.

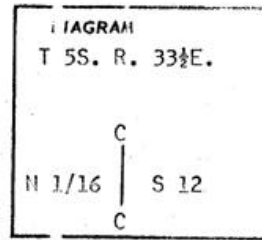

No record of subsequent remonumentation found in County Records.

Description of corner evidence found:


None.

Description of monument and accessories established to perpetuate the original location of this corner:

Set 2 1/2" x 30" iron pipe 25" in ground with a brass cap marked as shown: from which I scribed Bearing Trees.

A fir 10" diameter bears South 68°21' West 108.70 feet marked C N 1/16 S 12 BT  
A fir 16" diameter bears South 11° East 118.60 feet marked C N 1/16 S 12 BT

I nailed a brass washer marked PLS 933 to the BT blaze of both trees. Set steel post 3 feet West of corner. The corner is North 95 feet of an East-West fence line. Used T-2 and steel tape, measuring a horizontal distance to the center of the Bearing Trees.

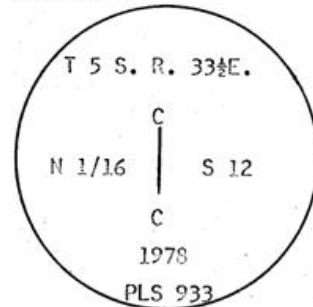

Office of ..... County Surveyor ..... County of Umatilla  
 State of Oregon ..... I hereby certify that the within instrument was filed in this office  
 for record on the ..... day of .....  
 ..... by .....  
 (COUNTY OFFICIAL) (DEPUTY)

f-23