

History of original corner establishment:

Corner established in 1882 by Rufus S. Moore under Contract No. 451.

40.00 chains set stone 18" x 18" x 18" for 1/4 Section corner from which:

A pine 8" diameter bears South 22° West 41 lks. dist.
A tamarack 10" diameter bears North 35° East 15 lks. dist.

No record of subsequent remonumentation found in County Records.



Description of corner evidence found:


None.

Description of monument and accessories established to perpetuate the original location of this corner

Set 2 1/2" x 30" iron pipe 24" in ground with brass cap marked as shown: from which I scribed new Bearing Trees.

A tamarack 16" diameter bears North 30°59' West 14.00 feet marked 1/4 S 11 BT.
A pine 32" diameter bears South 38°52' East 36.00 feet marked 1/4 S 12 BT.

I nailed a brass washer marked PLS 933 to the BT blaze of both trees. Set steel fence post 5 feet East of corner. The corner is North 48° East 200.00 feet of a road which runs Southeast by Northwest. Used T-2 and steel tape, measuring a horizontal distance to center of Bearing Tree.

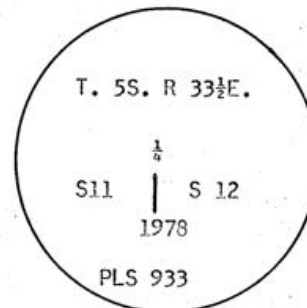

Office of.....County Surveyor..... County of.....Umatilla.....
State of.....Oregon....., I hereby certify that the within Instrument was filed in this office
for record on the day of,
..... by
(COUNTY OFFICIAL) (DEPUTY)

G-21