

CERTIFIED RECORD OF LAND CORNER MONUMENTATION


J-23

History of original corner establishment:

Corner established in 1882 by Rufus S. Moore, under Contract No. 451.

40.00 chains set stone 15" x 12" x 10" for 1/4 Section corner, from which:

- A pine 40" diameter bears North 34° East 193 lks.
- A pine 12" diameter bears South 20° East 260 lks.

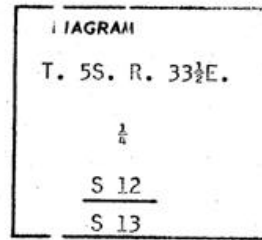

No record of subsequent remonumentation found in County Records.

Description of corner evidence found:


None.

Description of monument and accessories I established to perpetuate the original location of this corner

Set 2 1/2" x 30" iron pipe 12" in ground with brass cap marked as shown: raised stone mound around brass cap from which I scribed new Bearing Trees.

- A fir 16" diameter bears North 46°02' East 49.60 feet marked 1/4 S 12 BT.
- A pine 14" diameter bears South 76°22' West 85.70 feet marked 1/4 S 13 BT.

I nailed a brass washer marked PLS 933 to BT blaze of both trees. Set steel fence post 5 feet West of corner. The corner is North 38° West 210 feet of a road which runs North-South. Used T-2 and steel tape, measuring a horizontal distance to the center of the Bearing Trees.

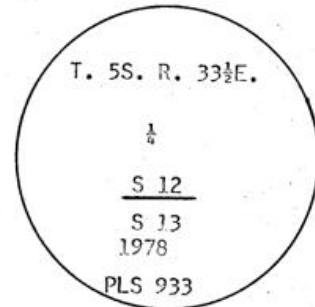

Office of County Surveyor County of Umatilla
 State of Oregon, I hereby certify that the within instrument was filed in this office
 for record on the day of
 by
 (COUNTY OFFICIAL) (DEPUTY)

J-23

G-791