

Index File No. F-9

CORNER RECORD (SEARCH)

(Ref. FSM 7151.4)

Tract or Survey No. _____ Cor. No. 1/16


T 59 R. 34E

R.D. LA GRANDE County UNION

Merid. WM

N.F. W-W State OREGON WC 1/16 Cor. of SECTION 9

CORNER DIAGRAM

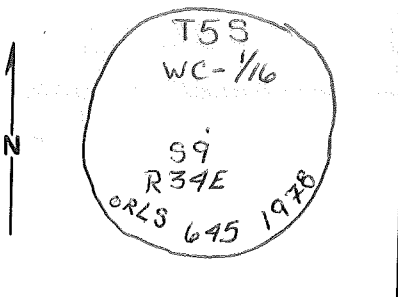

DESCRIBE CORNER MONUMENT FOUND

2 1/2" GALV. PIPE W/ BRASS CAP
GOOD SHAPE

DESCRIBE BEARING TREES OR OTHER OFFICIAL ACCESSORIES FOUND

ALL B.T.'S ARE IN GOOD SHAPE

PHOTO IDENTIFICATION DATA

Photo No. _____
Filed At. _____
Object Ident. _____
Ident. By _____

Signature

DESCRIBE CORNER LOCATION RELATIVE TO NEAR-BY FEATURES, ALSO HOW TO REACH CORNER

PLANE COORDINATE POSITION DATA

State _____ Zone _____
X _____
Y _____
Estab. By _____

Agency

Signature

EARL E. STRANG

Title

CET

Division

LLL

Headquarters

GREZ

Date

7/26/93

7100-52-(3/68)

CORNER RECORD (PERPETUATION)

MONUMENT: DESCRIBE NEW MONUMENT SET, OR WORK DONE TO PRESERVE EXISTING MONUMENT

ACCESSORIES: DESCRIBE NEW BT'S WITNESS OBJECTS ETC. ESTABLISHED, OR WORK DONE TO PRESERVE EXISTING EVIDENCE

ALL B.T.'S ARE IN GOOD SHAPE
REPAINTED 6" RED BAND AND BLAZES ON B.T.'S

Work Done By _____ Title _____ Date _____ State Registration No. or Agency _____

Certified Cor. Record Prepared? Yes No Filed At: _____ Date _____

REMARKS

Index File No. F-9 T. 55 R. 34E M. WM

Tract or Surv. No.

WC/Cor. of
SECT. 9

Index
File No. F9
T 5S R. 34E
Merid. _____

CORNER RECORD (SEARCH)

(Ref. FSM 7151.4)

R.D. LAGRADE County UNION
N.F. W-W State OREGON

Tract or Survey No. _____
Cor. No. S 1/16 S8E9

CORNER DIAGRAM

CAP STAMPED



T5S

S 1/16

S8 | S9

R34E

ORLS 645

DESCRIBE CORNER MONUMENT FOUND

NONE

DESCRIBE BEARING TREES OR OTHER OFFICIAL ACCESSORIES FOUND

NONE

PHOTO IDENTIFICATION DATA

Photo No. _____
Filed At. _____
Object Ident. _____
Ident. By _____

Signature

DESCRIBE CORNER LOCATION RELATIVE TO NEAR-BY FEATURES, ALSO HOW TO REACH CORNER

This CARD MADE FROM CERT RECORD
ON FILE IN T4S R35E
E STRANG 1-93

PLANE COORDINATE POSITION DATA

State _____ Zone _____
X _____
Y _____
Estab. By _____

Agency

Signature

Title

Division

Headquarters

Date

FS-7100-52 (3/68)

CORNER RECORD (PERPETUATION)

MONUMENT: DESCRIBE NEW MONUMENT SET, OR WORK DONE TO PRESERVE EXISTING MONUMENT

2 1/2" BASS CAP ON A 30" GALV. IRON PIPE WITH LARGE MOUND OF STONE PLACED AROUND MONUMENT

ACCESSORIES : DESCRIBE NEW BT'S WITNESS OBJECTS ETC. ESTABLISHED, OR WORK DONE TO PRESERVE EXISTING EVIDENCE

A 5" DIA PINE S62°W, 41.98FT SCRIBED 1/16 58 BT
 A 6" DIA PINE S53°E, 62.98FT SCRIBED 1/16 59 BT

Work Done By JIM HAMLETON Title OPLS CLAS Date 8/78 State Registration No. or Agency _____

Certified Cor. Record Prepared? Yes No Filed At: _____ Date _____

REMARKS

Index File No. T. R. M. Tract or Surv. No. Cor.